

JACKSON

Ø169

8-31-70

MISSISSIPPI BOARD OF WATER COMMISSIONERS 416 North State Street Jackson, Mississippi 39201

CODED

WATER WELL DRILLERS LOG

8-31 1970 Coast Water Well Service Jackson date well completed firm name county well located

LANDOWNER: J. N. Hermany

331 Beardslee

Mass Point Miss (mailing address)

description of formations encountered

from to

Red mud - coarse 0 159

blue clay 159 340

Red - fine - mud 340 388

WELL LOCATION:

sec. 19 T. 8 S R. 7 W 7 miles SW of Ocean Springs (distance) (direction) (nearest town)

WELL PURPOSE: Home (home, irrigation, municipal, industrial)

WELL COMPLETION DATA:

- (1) diameter (inches) 2"
(2) total depth (feet) 388'
(3) static water level (feet) 19 below top of ground.
(4) casing (material) galv, (depth) 378', (size) 2" if telescope see back.
(5) screen (length) 10', (depth to top) 378", (size) 2", (material) stainless barlug
(6) pump (HP) 1, (yield gpm) 12
(7) electric log (yes or no) No.

CODED

JAN 19 1971

MISS. BU. OF WATER COMM.


(organization running log)

(8) how well bottom plugged Backwash Valve

DRILLERS REMARKS:

If well telescopes please sketch and show depths.

GROUND LEVEL

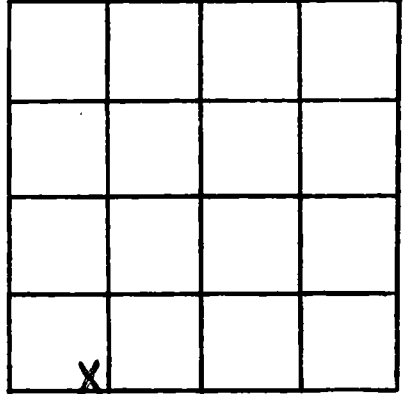

SECTION 19

Please indicate well location X.

ADDITIONAL INFORMATION

A series of horizontal lines for writing additional information.

If more than one screen, show locations of each on sketch.