

CODED

FEB 16 1971

JACKSON
 #174
 11-20-70

MISSISSIPPI
 BOARD OF WATER COMMISSIONERS
 416 North State Street
 Jackson, Mississippi 39201

MISS. BD. OF
 WATER COMM.

WATER WELL DRILLERS LOG

Nov 20 1970 date well completed Cobille Water Supply firm name Jackson county well located

LANDOWNER: B. Ruth
J. Dodge
Franklin Beach Miss
 (mailing address)

description of formations encountered	from	to
sand	0	108
wood	108	111
clay	111	195
sand	195	237
clay	237	252
fine sand	252	405
clay	405	435
sand	435	468

WELL LOCATION:
 sec. 19 T. 8 N. R. 7 E
9 miles West of Passburg
 (distance) (direction) (nearest town)

WELL PURPOSE: home
 (home, irrigation, municipal, industrial)

WELL COMPLETION DATA:

(1) diameter (inches) 2

(2) total depth (feet) 468

(3) static water level (feet) 8-2 ^{below} _{above} top of ground.

(4) casing galv 463
 (material) (depth)
 (size) if telescope see back.

(5) screen 5 463
 (length) (depth to top)
2 stainless
 (size) (material)

(6) pump 1/2 10
 (HP) (yield gpm)
elec
 (type power)

(7) electric log no
 (yes or no)
 (organization running log)


(8) how well bottom plugged BP Valley

CODED

DRILLERS REMARKS:

If well telescopes please sketch and show depths.

GROUND LEVEL

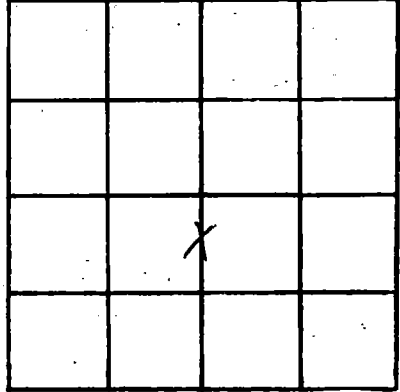

irregular section
SECTION 19

Please indicate well location X.

ADDITIONAL INFORMATION

If more than one screen,
show locations of each on sketch.