

CODED

FEB 16 1971

MISS. BD. OF WATER COM.

MISSISSIPPI BOARD OF WATER COMMISSIONERS 416 North State Street Jackson, Mississippi 39201

WATER WELL DRILLERS LOG

JACKSON

Ø 175

12-8-70

12-8 date well completed

1970 Coast Water Well Serv firm name

Jackson county well located

LANDOWNER: Hunter R. Horner

description of formations encountered

from

to

P.O. Box 343-A-1

top soil

0

12

Ocean Springs, Miss. (mailing address)

sand-med-coarse

12

72

WELL LOCATION:

Blue clay

72

170

sec 17 T 7 N R 7 E S W 6 miles N.E. of Ocean Springs (distance) (direction) (nearest town)

sand fine to med.

170

190

WELL PURPOSE: home (home, irrigation, municipal, industrial)

WELL COMPLETION DATA:

(1) diameter (inches) 2"

(2) total depth (feet) 190'

(3) static water level (feet) 17 below top of ground.

(4) casing PVC, 180' (material) (depth)

2" (size) If telescope see back.

(5) screen 10' 180' (length) (depth to top)

2" PVC (size) (material)

(6) pump 1/2 8 (HP) (yield gpm)

elec. (type power)

(7) electric log NO (yes or no)


(organization running log)

(8) how well bottom plugged backwash valve

DRILLERS REMARKS:

CODED

If well telescopes please sketch and show depths.

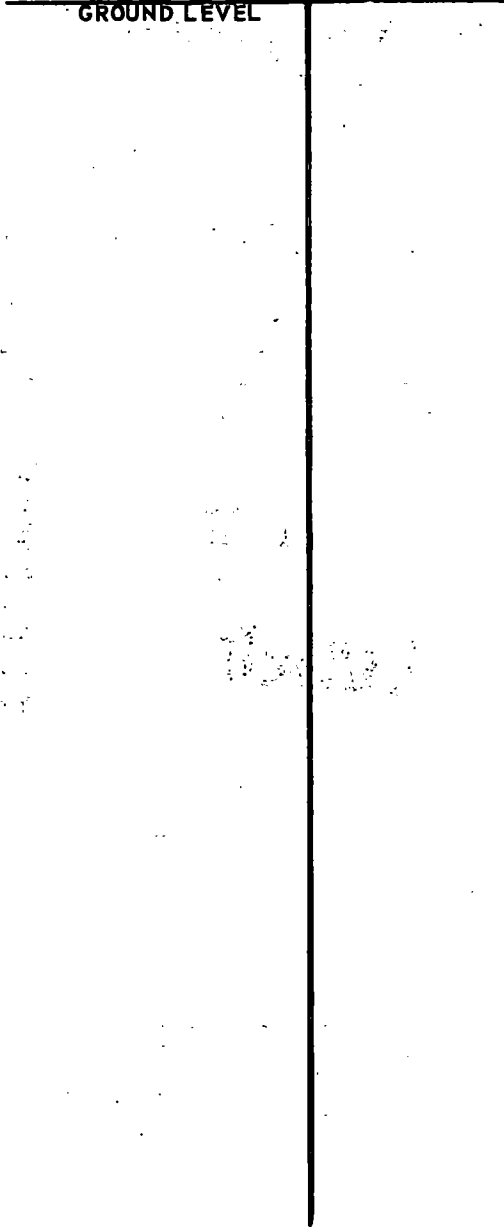

		X	

SECTION 17

Please indicate well location X.

ADDITIONAL INFORMATION

Lined area for additional information.

If more than one screen, show locations of each on sketch.