

179 *can't locate*

**CODED**

5-18-62

WATER WELL DRILLERS LOG

2603


Date: May 18, 1962, Driller: Andrew Colville County Jackson  
(Name)

(1) Owner of Land: <u>S.W. Snow</u> (Name) <u>Sautier</u> (Address) <u>3677</u>	Description & Color of Materials Sand, Clay, Red Clay, Shell, etc.	Thick- ness Feet	Depth Feet
(2) Location: <u>NW 1/4, NW 1/4, Sec. 7 T2R5</u> _____ miles _____, of _____ (distance) (direction) (Nearest Town)	21 - 28 <u>clay</u>		
	28 - 39 <u>sand</u>		
(3) Topography: <u>Hilly</u> (Hilly) (Flat) (Level)	39 - 42 <u>clay</u>		
	42 - 52 <u>clay</u>		
(4) Purpose of Well: <u>Domestic</u> (Domestic Irrigation Municipal, Industrial, Other)	52 - 63 <u>sand</u>		
	63 - 68 <u>sand</u>		
	<u>TD</u>		

Information upon completion of well:

- (1) Diameter 1 1/4 inches.
- (2) Total Depth 68 feet.
- (3) Water Level 20' feet below top of ground.
- (4) Cased to \_\_\_\_\_, Size \_\_\_\_\_
- (5) Screen: Size 1 1/4, Length 10'
- (6) Were any formations sealed against pollution?  
\_\_\_\_\_ yes, X no.

**CODED**

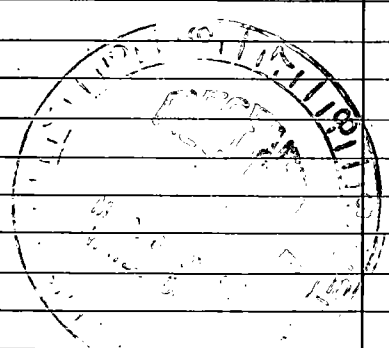

If YES depth of formation \_\_\_\_\_  
Why \_\_\_\_\_  
Drillers Remarks: \_\_\_\_\_

Well No. 179

(Use Back Side)

