

0183  
3-17-64

WATER WELL DRILLERS LOG

3862

CODED

Date: 3-17, 1964, Driller: H.O. Ridgell County Jackson  
(Name)

(1) Owner of Land: E.E. McEachern  
(Name)

Star Route Denton Miss  
(Address) 3477

(2) Location: 1/4, 1/4, Sec. 0 T 7 R 7

7 miles West of Poyoula  
(distance) (direction) (Nearest Town)

(3) Topography:  (Hilly)  (Flat)  (Level)

(4) Purpose of Well: Home  
(Domestic Irrigation Municipal, Industrial, Other)

Description & Color of Materials Sand, Clay, Red Clay, Shell, etc.	Thick- ness Feet	Depth Feet
Clay	10	10
Fine white sand	8	18
Blue Clay	15	33
Med. sand	15	68

CODED

Information upon completion of well:

(1) Diameter 1 1/4 inches.

(2) Total Depth 68 feet.

(3) Water Level 15 feet below top of ground.

(4) Cased to —, Size —


(5) Screen: Size 1 1/4", Length 5'

(6) Were any formations sealed against pollution?  
no.

If YES depth of formation.

Why

Drillers Remarks:

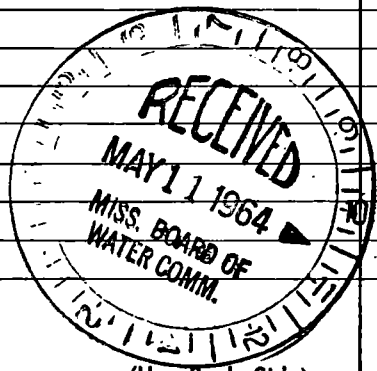

(Use Back Side)

Well No.

