

#184

WATER WELL DRILLERS LOG

CODED

5-15-64

761

Date: 5-15-64, 1964, Driller: C. T. SWITZER WELL CO. County: Jackson

(Name)

(1) Owner of Land: Larry J. Finley
 (Name)
Mountain View New Springs
 (Address)

(2) Location: 1/4, 1/4, Sec. 8 T7 R7,
 _____ miles _____ of _____
 (distance) (direction) (Nearest Town)

(3) Topography: (Level)
 (Hilly) (Flat)

(4) Purpose of Well: Domestic
 (Domestic Irrigation
 Municipal, Industrial, Other)

Description & Color of Materials Sand, Clay, Red Clay, Shell, etc.	Thick- ness Feet	Depth Feet
<u>Just 146' already drilled</u>		
<u>sand</u>	<u>146</u>	<u>146</u>
<u>clay</u>	<u>162</u>	<u>166</u>
<u>sand, gravel</u>	<u>166</u>	<u>224</u>
<u>clay</u>	<u>224</u>	<u>241</u>
<u>sand</u>	<u>241</u>	<u>251</u>
<u>clay</u>	<u>251</u>	<u>284</u>
<u>clay w/ sand sh</u>	<u>284</u>	<u>307</u>
<u>sand & clay</u>	<u>307</u>	<u>329</u>
<u>clay</u>	<u>329</u>	<u>363</u>
<u>sand</u>	<u>363</u>	<u>369</u>
<u>sand, gravel</u>	<u>369</u>	<u>510</u>
<u>sand</u>	<u>510</u>	<u>514</u>
<u>clay</u>	<u>514</u>	<u>528</u>
<u>sand</u>	<u>528</u>	<u>530</u>
<u>shale</u>	<u>530</u>	<u>555</u>
<u>sand, gravel</u>	<u>555</u>	<u>590</u>

Information upon completion of well:

(1) Diameter 2 inches.

(2) Total Depth 590 feet.

(3) Water Level 4' feet below top of ground.

(4) Cased to 590', Size 2"


(5) Screen: Size 2", Length 10'

(6) Were any formations sealed against pollution?
 yes, _____ no.

If YES depth of formation _____
 Why Health Dept. requirements

Drillers Remarks: _____

CODED

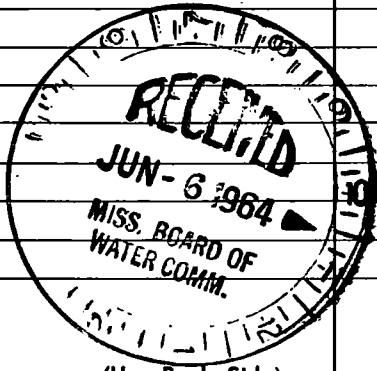

(Use Back Side)

Well No.

1950

1950

1950

1950