

Φ 185
4-16-65

WATER WELL DRILLERS LOG

CODED

3017

Date: 4-16-65 1965, Driller: C. T. Surtzow Well Co County Jackson
(Name)

(1) Owner of Land: G. A. Stockman
(Name)
Highway 57 Ocean Springs
(Address)

(2) Location: 1/4, 1/4, Sec. 7 T8 R 7
_____ miles _____ of _____
(distance) (direction) (Nearest Town)

(3) Topography: _____
(Hilly) (Flat) (Level)

(4) Purpose of Well: domestic
(Domestic Irrigation
Municipal, Industrial, Other)

Description & Color of Materials Sand, Clay, Red Clay, Shell, etc.	Thick- ness Feet	Depth Feet
Clay	0	10
Sand	10	21
Sand, fair	21	63
Sand + clay streaks	63	84
Sand, good	84	126
Clay	126	194
Sand	194	210
Sand, good	210	231

Information upon completion of well:

(1) Diameter 2" inches.

(2) Total Depth 231' feet.

(3) Water Level 19' feet below top of ground.

(4) Cased to 231', Size 2"

(5) Screen: Size 2", Length 10' 8"


(6) Were any formations sealed against pollution?
X yes, _____ no.

If YES depth of formation _____

Why Health Dept. Requirement

Drillers Remarks: _____

CODED

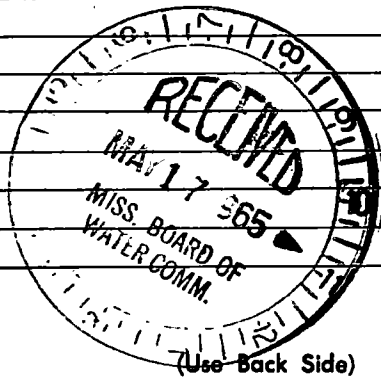

Well No.

Handwritten text at top left, possibly a name or address.

Handwritten text at top center, possibly a date or location.

Handwritten text at top right, possibly a name or address.

Vertical list of handwritten numbers or codes on the left side.

Vertical list of handwritten text or names in the middle-left section.

Large handwritten text block in the upper right quadrant.

Small handwritten text block in the middle-right section.

Handwritten text block in the lower-left quadrant.

Large handwritten text block in the lower-right quadrant.

Handwritten text block at the bottom right of the page.