

P 0186  
5-14-65

1921 3833

WATER WELL DRILLERS LOG

**CODED**

Date: 5/14, 1965, Driller: Hattiesburg Butte County Jackson  
(Name)

(1) Owner of Land: Belle J Lofton  
(Name)  
Yautie, Miss.  
(Address)

(2) Location: 1/4, 1/4, Sec. 12 T7R7,  
\_\_\_\_\_ miles \_\_\_\_\_ of \_\_\_\_\_  
(distance) (direction) (Nearest Town)

(3) Topography: \_\_\_\_\_  
(Hilly) (Flat) (Level) X

(4) Purpose of Well: domestic  
(Domestic Irrigation  
Municipal, Industrial, Other)

Description & Color of Materials Sand, Clay, Red Clay, Shell, etc.	Thick- ness Feet	Depth Feet
<u>yellow clay</u>	<u>0-8</u>	
<u>white sand</u>	<u>8-15</u>	
<u>Blue clay</u>	<u>15-145</u>	
<u>Blue sand</u>	<u>145-155</u>	
<u>Blue clay</u>	<u>155-180</u>	
<u>Blue sand</u>	<u>180-250</u>	

Information upon completion of well:


- (1) Diameter 9 inches.
- (2) Total Depth 250 feet.
- (3) Water Level 19 feet below top of ground.
- (4) Cased to \_\_\_\_\_, Size \_\_\_\_\_
- (5) Screen: Size 2", Length 10'
- (6) Were any formations sealed against pollution?  
\_\_\_\_\_ yes, X no.

If YES depth of formation \_\_\_\_\_

Why \_\_\_\_\_

Drillers Remarks: \_\_\_\_\_

**CODED**

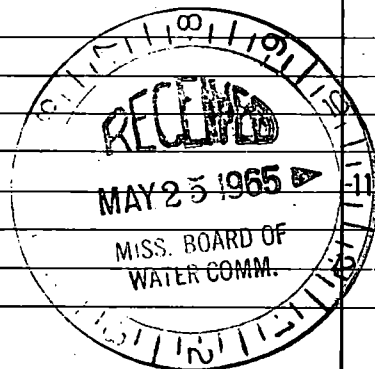

(Use Back Side)

Well No.

0000

0000