

187

11-11-65

2752

WATER WELL DRILLERS LOG

CODED

Date: *11-11-65*, 19___, Driller: *C. T. Buntjer Well Co* County *Jackson*
(Name)

(1) Owner of Land: *Bert Phelps Jr*
(Name)
Bert Phelps off Highway 90 Center
(Address)

(2) Location: ___ 1/4, ___ 1/4, Sec. *36* T *7* R *7*,
 ___ miles ___ of ___
(distance) (direction) (Nearest Town)

(3) Topography: *X*
(Hilly) (Flat) (Level)

(4) Purpose of Well: *domestic*
(Domestic Irrigation
 Municipal, Industrial, Other)

Description & Color of Materials Sand, Clay, Red Clay, Shell, etc.	Thick- ness Feet	Depth Feet
<i>Clay</i>	<i>0</i>	<i>49</i>
<i>Sand</i>	<i>49</i>	<i>80</i>
<i>Clay</i>	<i>80</i>	<i>130</i>
<i>Sand</i>	<i>130</i>	<i>140</i>
<i>Clay</i>	<i>140</i>	<i>200</i>
<i>Sand</i>	<i>200</i>	<i>270</i>

Information upon completion of well:

(1) Diameter *2*" inches.

(2) Total Depth *270* feet.

(3) Water Level *13'* feet below top of ground.

(4) Cased to *270'*, Size _____

(5) Screen: Size *2"*, Length *10' 8 1/2"*


(6) Were any formations sealed against pollution?
X yes, ___ no.

If YES depth of formation _____

Why *Health Dept. Permits*

Drillers Remarks: _____

CODED

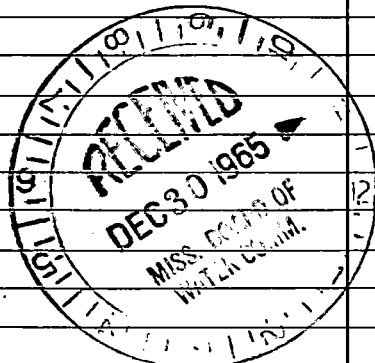

(Use Back Side)

Well No.

100

100

