

0188

11-20-65

WATER WELL DRILLERS LOG

3841

**CODED**

Date: 11-20, 1965, Driller: Coast Water Well Service County Jackson  
(Name)


(1) Owner of Land: Barbara Ross  
(Name)  
Star Route Gautier Miss  
(Address)  
24 7th  
 (2) Location: 1/4, 1/4, Sec. O T 8 R 7  
4 miles north, of Gautier  
(distance) (direction) (Nearest Town)  
 (3) Topography:  (Level)  
(Hilly) (Flat) (Level)  
 (4) Purpose of Well: Home  
(Domestic Irrigation Municipal, Industrial, Other)

Description & Color of Materials Sand, Clay, Red Clay, Shell, etc.	Thick- ness Feet	Depth Feet
Red Clay	21	21
Fine sand	21	42
Blue Clay	42	84
Sandy shells	80	164
Fine red sand	30	194

Information upon completion of well:

(1) Diameter 1 1/4 inches.  
 (2) Total Depth 194 feet.  
 (3) Water Level 12 feet below top of ground.  
 (4) Cased to \_\_\_\_\_, Size \_\_\_\_\_  
 (5) Screen: Size 1 1/4", Length 5'  
 (6) Were any formations sealed against pollution?  
 \_\_\_\_\_ yes, X no.  
 If YES depth of formation \_\_\_\_\_  
 Why \_\_\_\_\_  
 Drillers Remarks: \_\_\_\_\_

**CODED**

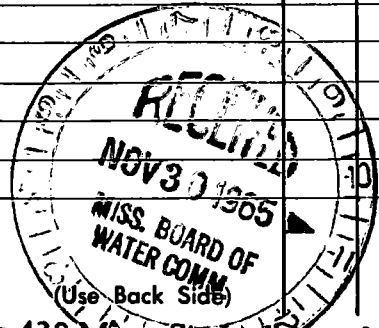

Well No.

