

JACKSON MISSISSIPPI BOARD OF WATER COMMISSIONERS

CODED

Ø189

4-18-66

WATER WELL DRILLERS LOG

3829

Date: 4-18, 1966, Driller: H.O. Rydell County Jackson
Coast Water Well Dr.

(1) Owner of Land: H.O. Rouse
 (Name)
Dauter, Miss.
 (Address)
Perkinson College

(2) Location: 1/4, 1/4, Sec. 10 T7R7
12 miles West of Pascagoula
 (distance) (direction) (Nearest Town)

(3) Topography: (Level)
 (Hilly) (Flat)

(4) Purpose of Well: Home
 (Domestic Irrigation
 Municipal, Industrial, Other)

Description & Color of Materials Sand, Clay, Red Clay, Shell, etc.	Thick- ness Feet	Depth Feet
<u>Red Clay</u>	<u>21</u>	<u>21</u>
<u>Blue Clay</u>	<u>21</u>	<u>42</u>
<u>Sand Mal-conse</u>	<u>84</u>	<u>126</u>
<u>Blue clay shale</u>	<u>21</u>	<u>147</u>
" " "	<u>21</u>	<u>168</u>
" " "	<u>21</u>	<u>189</u>
" " "	<u>7</u>	<u>196</u>
<u>Sand Mal-conse</u>	<u>24</u>	<u>220</u>

Information upon completion of well:

(1) Diameter 2 inches.

(2) Total Depth 220 feet.


(3) Water Level 14 feet below top of ground.

(4) Cased to _____, Size _____

(5) Screen: Size 2", Length 10'

(6) Were any formations sealed against pollution?
 _____ yes, no.

CODED

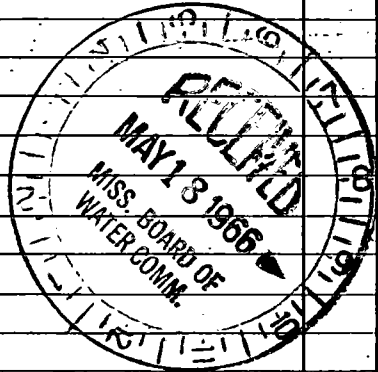

If YES depth of formation _____

Why _____

Drillers Remarks: _____

Well No.

(Use Back Side)

