

190

1920 3838

WATER WELL DRILLERS LOG

CODED

4-31-66

Date: 4-31, 1966, Driller: H.O. Ritz del County Jackson Coast Water Well Co.

(1) Owner of Land: Arnon Taylor
 (Name)
Gautier, Miss
 (Address)

(2) Location: 1/4, 1/4, Sec. 12 T. 7 R. 7
8 miles N. West of Passapatan
 (distance) (direction) (Nearest Town)

(3) Topography: (Hilly) (Flat) (Level)

(4) Purpose of Well: (Domestic Irrigation) (Municipal, Industrial, Other)

Description & Color of Materials Sand, Clay, Red Clay, Shell, etc.	Thick- ness Feet	Depth Feet
Red Clay	12	12
Fine Sand	9	21
Blue Clay	21	42
Fine sand	21	63
" "	21	84
Fine - medium	21	105
" " "	21	126
" " "	21	147
" " "	21	168
" " "	21	189
Med. coarse sand	21	210
" " "	21	231
" " "	10	241

Information upon completion of well:

(1) Diameter 2 inches.

(2) Total Depth 241 feet.


(3) Water Level 10 feet below top of ground.

(4) Cased to _____, Size _____

(5) Screen: Size 2", Length 10'

(6) Were any formations sealed against pollution?
 _____ yes, no.

CODED

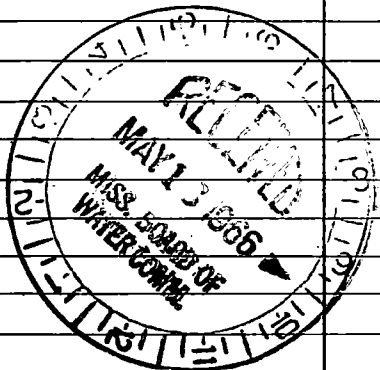

If YES depth of formation _____

Why _____

Drillers Remarks: _____

(Use Back Side)

Well No.

0000