

JACKSON MISSISSIPPI BOARD OF WATER COMMISSIONERS

Φ 192
6-15-66

764
WATER WELL DRILLERS LOG

CODED


Date: 6-15-, 1966, Driller: Hattiesburg Butte Jackson
(Name)

(1) Owner of Land: Albert Holbrook
(Name)
Rt 3 Ocean Springs
(Address)
Fountainbleau Acres
(2) Location: 1/4, 1/4, Sec. 8, T7R2,
near Hattiesburg
miles of (Nearest Town)
(distance) (direction) (Level)
(3) Topography: X
(Hilly) (Flat) (Level)
(4) Purpose of Well:
(Domestic Irrigation
Municipal, Industrial, Other)

Description & Color of Materials Sand, Clay, Red Clay, Shell, etc.	Thick- ness Feet	Depth Feet
<u>Yellow Clay</u>	<u>0-39</u>	
<u>Yellow Sand</u>	<u>39-45</u>	
<u>Yellow Clay</u>	<u>45-90</u>	
<u>Blue clay</u>	<u>90-145</u>	
<u>Blue Sand</u>	<u>145-165</u>	

Information upon completion of well:

(1) Diameter 2 inches.
(2) Total Depth 165 feet.
(3) Water Level 23 feet below top of ground.
(4) Cased to _____, Size _____
(5) Screen: Size 2", Length 10'
(6) Were any formations sealed against pollution?
_____ yes, X no.

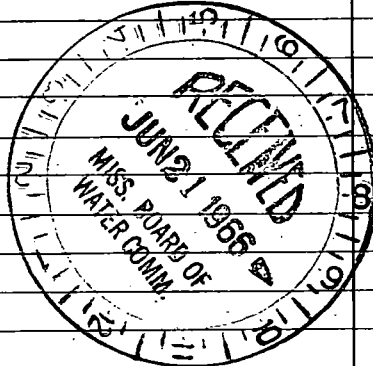

CODED

If YES depth of formation _____
Why _____
Drillers Remarks: _____

(Use Back Side)

Well No.

1945

1945

