

JACKSON
 193
 2-4-71

MISSISSIPPI
 BOARD OF WATER COMMISSIONERS
 416 North State Street
 Jackson, Mississippi 39201

CODED

WATER WELL DRILLERS LOG

2-4 1971 *Count Water Well Drains* *Jackson*
 date well completed firm name county well located

LANDOWNER:	description of formations encountered	from	to
<i>Don count</i>	<i>top soil + clay</i>	<i>0</i>	<i>47</i>
<i>Upside Restaurant</i>	<i>sand mud to coarse</i>	<i>47</i>	<i>119</i>
<i>Sautier Miss.</i> (mailing address)	<i>blue clay</i>	<i>119</i>	<i>222</i>
WELL LOCATION: sec. <i>35</i> T. <i>7</i> N. R. <i>7</i> W. <i>5</i> miles <i>W</i> of <i>Prosser</i> (distance) (direction) (nearest town)	<i>sand mud to coarse</i>	<i>222</i>	<i>315</i>
WELL PURPOSE: <i>Restaurant</i> (home, irrigation, municipal, industrial)	<i>blue clay</i>	<i>315</i>	<i>525</i>
WELL COMPLETION DATA:	<i>sand - mud to coarse</i>	<i>525</i>	<i>556</i>
(1) diameter (inches) <i>2"</i>			
(2) total depth (feet) <i>556</i>			
(3) static water level (feet) <i>21</i> below above top of ground.			
(4) casing <i>gal</i> (material) <i>546'</i> (depth)			
<i>2"</i> (size) if telescope see back.			
(5) screen <i>10'</i> (length) <i>546'</i> (depth to top)			
<i>2"</i> (size) <i>stainless henlog</i> (material)			
(6) pump <i>1</i> (HP) <i>12</i> (yield gpm)			
<i>etc.</i> (type power)			
(7) electric log <i>no</i> (yes or no)			
(organization running log)			
(8) how well bottom plugged <i>back - Wash valve</i>			
DRILLERS REMARKS:			


CODED

MAY 1971

MISS. BD. OF WATER COM.

If well telescopes please sketch and show depths.

GROUND LEVEL

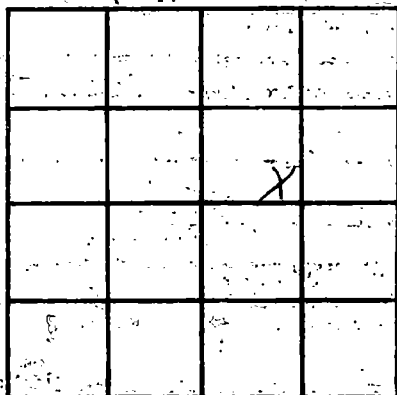

SECTION 35

Please indicate well location X.

ADDITIONAL INFORMATION

If more than one screen, show locations of each on sketch.