

JACKSON
 Ø 195
 4-12-71

MISSISSIPPI
 BOARD OF WATER COMMISSIONERS
 416 North State Street
 Jackson, Mississippi 39201

CODED

WATER WELL DRILLERS LOG

4-12 date well completed 1971 coast Water Well Service firm name Jackson county well located


LANDOWNER:	description of formations encountered	from	to
John Fritchett			
Pt. 2	top soil + clay	0	11
Ocean Springs, Miss. (mailing address)	fine sand	11	27
WELL LOCATION:	blue clay	27	138
sec. <u>5</u> T <u>7</u> S R <u>7</u> E	sand - fine to med.	138	178
<u>6</u> miles <u>S</u> of <u>Waltham</u>	blue clay	178	388
(distance) (direction) (nearest town)	sand - med. to coarse	318	388
WELL PURPOSE: <u>home</u> (home, irrigation, municipal, industrial)			
WELL COMPLETION DATA:			
(1) diameter (inches) <u>2"</u>			
(2) total depth (feet) <u>388</u>			
(3) static water level (feet) <u>35</u> below top of ground			
(4) casing <u>galv.</u> <u>378'</u> (material) (depth)			
<u>2"</u> if telescope see back. (size)			
(5) screen <u>10'</u> <u>378'</u> (length) (depth to top)			
<u>2"</u> <u>stainless steel</u> (size) (material)			
(6) pump <u>1</u> <u>12</u> (HP) (yield gpm)			
<u>elec.</u> (type power)			
(7) electric log <u>No</u> (yes or no)			
(organization running log)			
(8) how well bottom plugged <u>backwash valve</u>			
DRILLERS REMARKS:			

CODED

MAY 5 1971
 MISS. BD. OF
 WATER COM.

If well telescopes please sketch and show depths.

GROUND LEVEL

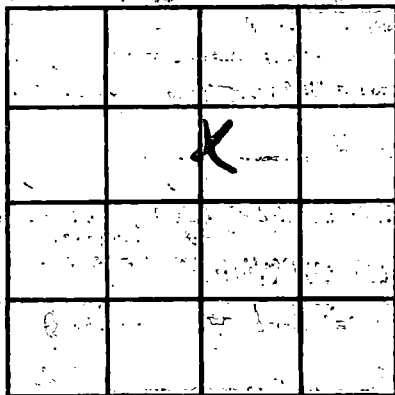

SECTION 5

Please indicate well location X.

ADDITIONAL INFORMATION

If more than one screen, show locations of each on sketch.