

JACKSON  
 1971  
 4-17-71

MISSISSIPPI  
 BOARD OF WATER COMMISSIONERS REC 21 1971  
 416 North State Street  
 Jackson, Mississippi 39201

**CODED**  
 D. OF  
 COMM

WATER WELL DRILLERS LOG

April 17 1971 Cobille Water Supply Jackson  
 Date well completed firm name county well located

LANDOWNER: John Wood  
Dauter, Miss  
 (mailing address)

description of formations encountered	from	to
<u>sand &amp; silt</u>	0	6
<u>clay</u>	6	68
<u>shale</u>	68	91

WELL LOCATION:  
 sec. 14 T. S N. R. 7 E.  
7 miles West of Paso  
 (distance) (direction) (nearest town)

WELL PURPOSE: Home  
 (home, irrigation, municipal, industrial)

WELL COMPLETION DATA:

(1) diameter (inches) 2

(2) total depth (feet) 91

(3) static water level (feet) 14.2 <sup>below</sup> above top of ground.

(4) casing galv 87  
 (material) (depth)  
 (size) if telescope see back.

(5) screen 4 87  
 (length) (depth to top)  
2 plastic  
 (size) (material)

(6) pump 3/4 8  
 (HP) (yield gpm)  
elec  
 (type power)

(7) electric log no  
 (yes or no)  
 (organization running log)

(8) how well bottom plugged BP Valve


**CODED**

DRILLERS REMARKS:

If well telescopes please sketch and show depths.

GROUND LEVEL

*irregular section*

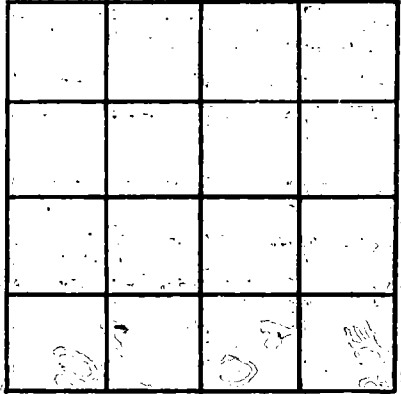

SECTION 14

Please indicate well location X.

ADDITIONAL INFORMATION

If more than one screen, show locations of each on sketch.