

MISSISSIPPI
BOARD OF WATER COMMISSIONERS
416 North State Street
Jackson, Mississippi 39201

CODED

WATER WELL DRILLERS LOG

JACKSON
Ø 206
5-19-72
MS-GW-07205

May 19 1972 Sutter Well Works Jackson
date well completed firm name county well located


LANDOWNER: <u>Seashore Utilities</u> <u>Gautier Utilities</u> Box 8127-Battelfield Sta.	Description of formations encountered	from	to
Jackson, Miss. (mailing address)	Sand-clay streaks	0	161
WELL LOCATION: sec <u>12</u> T <u>8</u> S R <u>7</u> W 1 miles west of Gautier (distance) (direction) (nearest town)	Clay Sand	161	310
WELL PURPOSE: sub-division (home, irrigation, municipal, industrial)	Clay	310	465
WELL COMPLETION DATA: (1) diameter (inches) <u>10" x 6"</u>	Sand	465	580
(2) total depth (feet) <u>773'</u>	Clay	580	703
(3) static water level (feet) <u>12'</u> below top of ground.	Sand	703	773
(4) casing <u>blk. steel</u> <u>773'</u> (material) (depth)			
<u>10" x 6"</u> if telescope see back. (size)			
(5) screen <u>40'</u> <u>773'</u> (length) (depth to top)			
<u>6" stainless steel</u> (size) (material)			
(6) pump <u>25</u> <u>300</u> (HP) (yield gpm)			
<u>elec.</u> (type power)			
(7) electric log <u>no</u> (yes or no)			
(organization running log)			
(8) how well bottom plugged <u>B.P. Valve</u>			
DRILLERS REMARKS:			

CODED

MS 24 7572

MISS. ED. WATER CO.

If well telescopes please sketch and show depths.

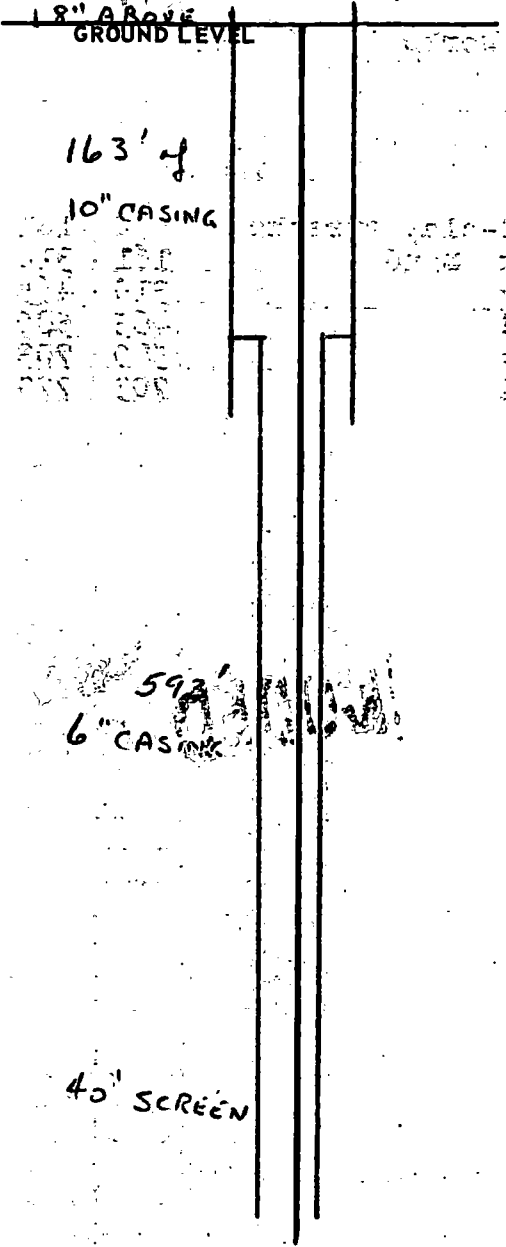

		X	

SECTION 12

Please indicate well location X.

ADDITIONAL INFORMATION

If more than one screen, show locations of each on sketch.