

Coded LOG # 203

MISSISSIPPI
BOARD OF WATER COMMISSIONERS
416 North State Street
Jackson, Mississippi 39201

JACKSON
Ø 208
11-6-72
GW-07201

WATER WELL DRILLERS LOG

Holland well Co JACKSON
firm name county well located

11-6-72
date well completed

on E-LOG ITS

LANDOWNER: W. F. Hutch Estate
Gardner 44 (Hillies)
Ferrell Homes Inc

PO BOX 717 (Pascagoula)
(mailing address)

WELL LOCATION:

sec. 24 T. 7 N R. 3 E
1 1/2 miles N (Hwy 90) (Gautier)
(distance) (direction) (nearest town)

WELL PURPOSE: Housing Project
(home, irrigation, municipal, industrial)

WELL COMPLETION DATA:

- (1) diameter (inches) 8
- (2) total depth (feet) 762
- (3) static water level (feet) 12 below above
top of ground.
- (4) casing 8 5/8 steel - 710 FT
(material) (depth)
- _____ if telescope see back.
(size)
- (5) screen 50 710
(length) (depth to top)
- 6" Johnson All
(size) Standard steel
- (6) pump 20 275
(HP) (yield gpm)
- Elec
(type power)
- (7) electric log Yes
(yes or no)
- MGS
(organization running log)
- (8) how well bottom plugged Backwash
Valve

description of formations encountered

from to

CLAY	0	10
SAND	10	45
CLAY	45	90
SAND	90	110
CLAY	110	422
SAND	422	475
CLAY	475	705
COARSE SAND	705	770
CLAY	770	800

Elec log shows West this extent


NOV 15 1972

DRILLERS REMARKS:

Excellent well

If well telescopes please sketch and show depths.

GROUND LEVEL

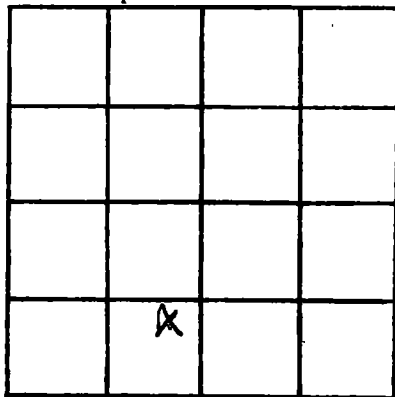

SECTION 4

Please indicate well location X.

ADDITIONAL INFORMATION

If more than one screen,
show locations of each on sketch.