

JACKSON
 Ø 210
 7-19-72

MISSISSIPPI
 BOARD OF WATER COMMISSIONERS
 416 North State Street
 Jackson, Mississippi 39201

WATER WELL DRILLERS LOG

CODED

July 19 1972 Polkville, W. Va. Jackson
 date well completed firm name county well located


LANDOWNER: <u>Mr. & Mrs. J. Hickey</u>	description of formations encountered	from	to
<u>Rainey, Ocean Springs</u> <u>Misses</u> (mailing address)	<u>Sand</u>	0	22
WELL LOCATION: sec <u>18</u> T <u>2</u> N R <u>7</u> E	<u>clay</u>	22	27
<u>6</u> miles <u>NE</u> of <u>Ocean Springs</u> (distance) (direction) (nearest town)	<u>Sand</u>	27	132
WELL PURPOSE: <u>farm home</u> (home, irrigation, municipal, industrial)	<u>clay</u>	132	280
WELL COMPLETION DATA:	<u>Sand</u>	350	284
(1) diameter (inches) <u>2</u>			
(2) total depth (feet) <u>384</u>			
(3) static water level (feet) <u>28</u> <u>below</u> above top of ground.			
(4) casing <u>galv.</u> , <u>379</u> , (material) (depth) <u> </u> If telescope see back. (size)			
(5) screen <u>2 1/2"</u> , <u>379</u> (length) (depth to top) <u>2 1/2"</u> , <u>stainless</u> (size) (material)			
(6) pump <u>10</u> , <u>10</u> (HP) (yield gpm) <u>elec.</u> (type power)			
(7) electric log <u>No</u> (yes or no) <u> </u> (organization running log)			
(8) how well bottom plugged <u>BR Valve</u>			
DRILLERS REMARKS:			

CODED

If well telescopes please sketch and show depths.

0400

GROUND LEVEL

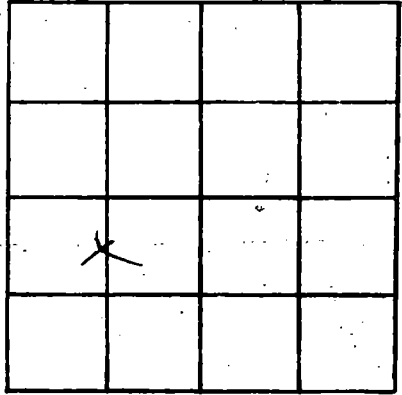

SECTION 3

Please indicate well location X.

ADDITIONAL INFORMATION

A series of horizontal lines providing space for additional information.

0400

If more than one screen, show locations of each on sketch.