

JACKSON

0217

7-12-72

MISSISSIPPI BOARD OF WATER COMMISSIONERS 416 North State Street Jackson, Mississippi 39201

WATER WELL DRILLERS LOG

7-12

date well completed

19

22 coast Water Well Sem. Jackson

firm name

county well located

LANDOWNER: John Matt line

P.O. Box 239

Gautier, Miss

(mailing address)

description of formations encountered

from

to

top soil

0 10

med. sand

10 35

gray sand

35 60

med. sand

60 95

Blue clay

95 120

fine to med. sand

120 140

clay

140 145

fine to med. sand

145 225

Blue clay + sand streaks

225 318

fine sand

318 328

Blue clay

328 359

fine sand

359 370

Blue clay

370 388

fine sand

388 399

clay

399 405

fine sand

405 430

Blue clay + streaks of sand

430 635

med. sand

635 673

WELL LOCATION:

sec. 14 T 7 S R 7 W 5 miles N of Gautier (distance) (direction) (nearest town)

WELL PURPOSE: Home (home, irrigation, municipal, industrial)

WELL COMPLETION DATA:


- (1) diameter (inches) 2"
(2) total depth (feet) 673'
(3) static water level (feet) 20' below top of ground
(4) casing galv. 2" (material) 663' (depth)
(5) screen 10' (length) 663' (depth to top) 2" Stainless (material)
(6) pump 1 (HP) 10 (yield gpm) elec. (type power)
(7) electric log NO (yes or no)
(organization running log)

(8) how well bottom plugged packwash valve

DRILLERS REMARKS:

If well telescopes please sketch and show depths.

GROUND LEVEL

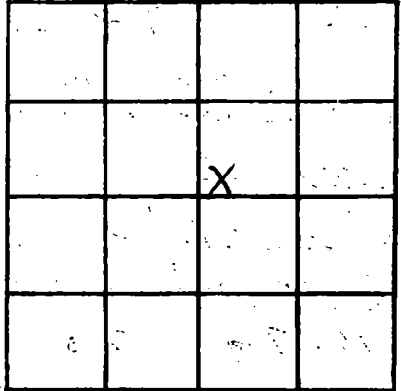

SECTION 14

Please indicate well location X.

ADDITIONAL INFORMATION

If more than one screen, show locations of each on sketch.