

JACKSON

Ø 218

8-16-72

MISSISSIPPI
 BOARD OF WATER COMMISSIONERS
 416 North State Street
 Jackson, Mississippi 39201

WATER WELL DRILLERS LOG

Aug 16 1972
date well completed

27 coast Water Well Dr. Jackson
firm name

Jackson
county well located

LANDOWNER: Ray Peterson

Pt. 1

description of formations encountered

from

to

Lautie, Miss.
(mailing address)

top soil 0 10

Blue clay 10 20

WELL LOCATION:

sec. 2 T. 8 S. R. 7 W.
4 miles W of Prosser
(distance) (direction) (nearest town)

fine sand 20 30

Blue clay + shells 30 84

WELL PURPOSE: home
(home, irrigation, municipal, industrial)

fine to med. sand 84 180

WELL COMPLETION DATA:

(1) diameter (inches) 2"

Blue clay 180 210

(2) total depth (feet) 290

(3) static water level (feet) 20' below top of ground

fine to coarse sand 210 290

(4) casing (material) plastic (depth) 280'

2" (size) if telescope see back.

(5) screen (length) 10' (depth to top) 280'

CODED

2" (size) plastic (material)

(6) pump (HP) 1/2 (yield gpm) 8

slc (type power)

(7) electric log (yes or no) no

(organization running log)


(8) how well bottom plugged Backwash valve

FEB 20 1973

DRILLERS REMARKS:

If well telescopes please sketch and show depths.

GROUND LEVEL

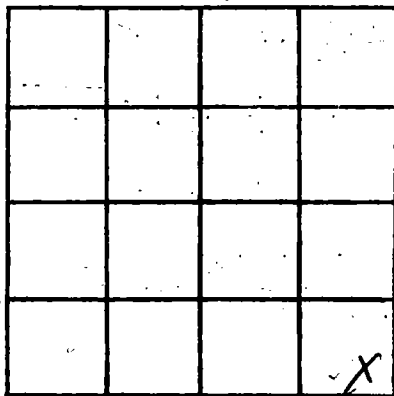

SECTION 9

Please indicate well location X.

ADDITIONAL INFORMATION

If more than one screen, show locations of each on sketch.