

JACKSON

Ø 220

9-20-72

MISSISSIPPI
 BOARD OF WATER COMMISSIONERS
 416 North State Street
 Jackson, Mississippi 39201

WATER WELL DRILLERS LOG

Sept. 20 19 72 Coast Water Well Dr. Jackson
 date well completed firm name county well located

LANDOWNER: Frank Hunter

description of formations encountered	from	to
---------------------------------------	------	----

Sautier, Miss
 (mailing address)

top soil	0	10
----------	---	----

WELL LOCATION:
 sec. 9 T. 8 N R. 7 E
 in Sautier
 (distance) miles (direction) of (nearest town)

medium sand	10	25
-------------	----	----

WELL PURPOSE: home
 (home, irrigation, municipal, industrial)

Blue clay	25	55
-----------	----	----

WELL COMPLETION DATA:

course sand + gravel	55	90
----------------------	----	----

(1) diameter (inches) 2"

blue clay	90	126
-----------	----	-----

(2) total depth (feet) 270'

med. sand	126	145
-----------	-----	-----

(3) static water level (feet) 21 below top of ground

Blue clay	145	185
-----------	-----	-----

(4) casing PVC, 280' (material) (depth)

fine to coarse sand + gravel	185	290
------------------------------	-----	-----

2" (size) If telescope see back.

(5) screen 10' (length) 280' (depth to top)

2" (size) PVC (material)

(6) pump (HP) Air Compress (yield gpm)

CODE

(type power) 20 GPM

(7) electric log NO (yes or no)

(organization running log)


(8) how well bottom plugged Backwash valve

FEB 20 1973

DRILLERS REMARKS:

If well telescopes please sketch and show depths.

GROUND LEVEL

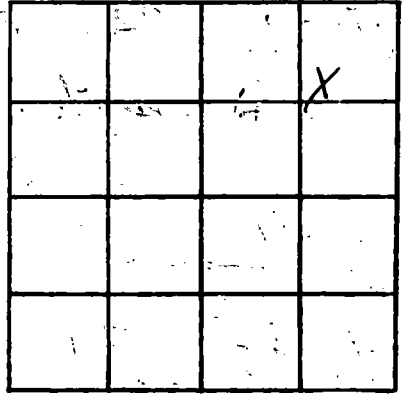

SECTION 9

Please indicate well location X.

ADDITIONAL INFORMATION

If more than one screen, show locations of each on sketch.