

**CODED**

JACKSON  
Ø 222  
6-1-73

MISSISSIPPI  
BOARD OF WATER COMMISSIONERS  
416 North State Street  
Jackson, Mississippi 39201

WATER WELL DRILLERS LOG

COAST WATER WELL SERVICE

Jackson

6/1 1973  
date well completed

firm name

county well located

LANDOWNER: Don Thomas  
Rt. 3  
Ocean Springs, Miss  
(mailing address)

description of formations encountered	from	to
<u>top soil</u>	<u>0</u>	<u>10</u>
<u>fine sand</u>	<u>10</u>	<u>25</u>
<u>blue clay</u>	<u>25</u>	<u>55</u>
<u>gravel</u>	<u>55</u>	<u>70</u>
<u>blue clay</u>	<u>70</u>	<u>125</u>
<u>med sand</u>	<u>125</u>	<u>189</u>
<u>blue clay</u>	<u>189</u>	<u>255</u>
<u>fine to med. sand</u>	<u>255</u>	<u>290</u>

WELL LOCATION:  
sec. 32 T 2 S R 7 W  
5 1/2 miles S.E. of Ocean Springs  
(distance) (direction) (nearest town)

WELL PURPOSE: Home  
(home, irrigation, municipal, industrial)

WELL COMPLETION DATA:

- (1) diameter (inches) 2"
- (2) total depth (feet) 290'
- (3) static water level (feet) 27 below above top of ground.
- (4) casing P.V.C., 280'  
(material) (depth)  
2" if telescope see back.  
(size)
- (5) screen 10', 280'  
(length) (depth to top)  
2", P.V.C.  
(size) (material)
- (6) pump \_\_\_\_\_  
(HP) (yield gpm)  
\_\_\_\_\_  
(type power)
- (7) electric log NO  
(yes or no)
- \_\_\_\_\_  
(organization running log)

**CODED**


(8) how well bottom plugged  
Backwash blue

DRILLERS REMARKS:

JUN 25 1973

0000  
If well telescopes please sketch and show depths.

GROUND LEVEL

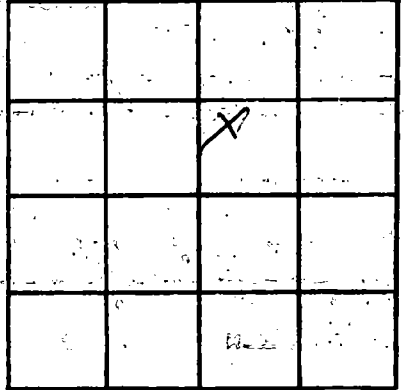

SECTION 32

Please indicate well location X.

ADDITIONAL INFORMATION

If more than one screen,  
show locations of each on sketch.