

**MISSISSIPPI
BOARD OF WATER COMMISSIONERS**
416 North State Street
Jackson, Mississippi 39201


CODED

JACKSON
Ø 229.
5-20-73

**WATER WELL DRILLERS LOG
COAST WATER WELL SERVICE**

5/20 1973 date well completed firm name Jackson county well located


LANDOWNER:	description of formations encountered	from	to
<u>Lloyd Royal</u>	<u>top soil</u>	<u>0</u>	<u>15</u>
<u>To Twin Screen Drive Lane</u>	<u>fine sand</u>	<u>15</u>	<u>30</u>
<u>Nautier Miss.</u>	<u>med. sand</u>	<u>80</u>	<u>115</u>
sec. <u>35</u> T. <u>7</u> M. R. <u>2</u> E. S. <u>W</u>	<u>blue clay</u>	<u>115</u>	<u>160</u>
<u>1</u> miles <u>east</u> of <u>Nautier</u> (distance) (direction) (nearest town)	<u>fine sand</u>	<u>160</u>	<u>190</u>
WELL PURPOSE: <u>house use</u> (home, irrigation, municipal, industrial)	<u>blue clay</u>	<u>190</u>	<u>220</u>
WELL COMPLETION DATA:	<u>coarse to med sand</u>	<u>220</u>	<u>315</u>
(1) diameter (inches) <u>4" X 2"</u>	<u>Blue Clay + streaks of sand</u>	<u>315</u>	<u>415</u>
(2) total depth (feet) <u>550'</u>	<u>fine sand</u>	<u>415</u>	<u>450</u>
(3) static water level (feet) <u>20</u> below top of ground.	<u>blue clay</u>	<u>450</u>	<u>508</u>
(4) casing <u>P.U.C.</u> , <u>530</u> , (material) (depth) <u>4" X 2"</u> If telescope see back. (size)	<u>fine to coarse sand</u>	<u>508</u>	<u>550</u>
(5) screen <u>20'</u> , <u>530'</u> (length) (depth to top) <u>2"</u> , <u>P.U.C.</u> (size) (material)			
(6) pump <u>1/2 H.P.</u> , <u>15</u> (HP) (yield gpm) <u>elec.</u> (type power)			
(7) electric log <u>NO</u> (yes or no)			
(organization running log)			
(8) how well bottom plugged <u>backed out blue</u>			
DRILLERS REMARKS:			

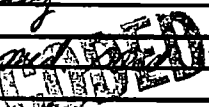

If well telescopes please sketch and show depths.

GROUND LEVEL

SCREENING DEPTH

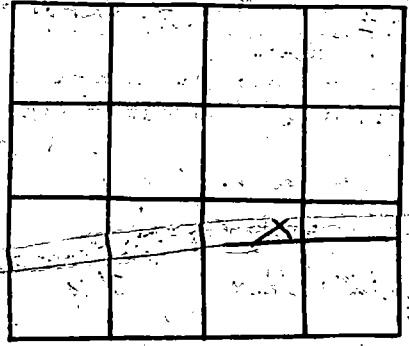

SECTION 35

Please indicate well location X.

ADDITIONAL INFORMATION

If more than one screen, show locations of each on sketch.