

Jackson
 Φ 236
 8-30-73

MISSISSIPPI
 BOARD OF WATER COMMISSIONERS
 416 North State Street
 Jackson, Mississippi 39201

CODED

WATER WELL DRILLERS LOG

8/30 1973 COAST WATER WELL SERVICE Jackson
 date well completed firm name county well located

LANDOWNER: Willie Frightman
P.O. Box 92
Lautier Ms.
 (mailing address)

description of formations encountered	from	to
<u>top soil + white clay</u>	<u>0</u>	<u>40</u>
<u>Sand - med. to coarse</u>	<u>40</u>	<u>120</u>

WELL LOCATION:
 sec. 9 T. 8 N. R. 7 E
in Lautier
 (distance) miles (direction) of (nearest town)

<u>Blue clay</u>	<u>120</u>	<u>215</u>
<u>Sand - med. to coarse</u>	<u>215</u>	<u>285</u>

WELL PURPOSE: Home
 (home, irrigation, municipal, industrial)

WELL COMPLETION DATA:

- (1) diameter (inches) 2"
- (2) total depth (feet) 285
- (3) static water level (feet) 21 below above-top of ground.
- (4) casing PVC, 275'
 (material) (depth)
2" if telescope see back.
 (size)
- (5) screen 10', 275
 (length) (depth to top)
2" PVC
 (size) (material)
- (6) pump 1/2 8
 (HP) (yield gpm)
elec.
 (type power)
- (7) electric log NO
 (yes or no)
 (organization running log)
- (8) how well bottom plugged Bill Value

CODED


SEP 21 1973

MISS. DIV. OF WATER CONTROL

DRILLERS REMARKS:

If well telescopes please sketch and show depths.

GROUND LEVEL

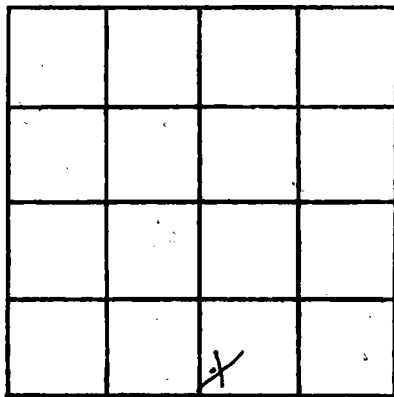

SECTION 9

Please indicate well location X.

ADDITIONAL INFORMATION

If more than one screen, show locations of each on sketch.