

JACKSON
 238
 8-15-73

MISSISSIPPI
 BOARD OF WATER COMMISSIONERS
 416 North State Street
 Jackson, Mississippi 39201

CODED

WATER WELL DRILLERS LOG

8-15 1973 date well completed
 Switzer Well Co. firm name
 JACKSON county well located


LANDOWNER: <u>Ann Benam</u>	description of formations encountered	from	to
<u>Rt. 3 Bx 276</u>			
<u>Ocean Springs, Miss.</u> (mailing address)	<u>clay</u>	<u>54</u>	<u>139</u>
WELL LOCATION:	<u>fine sand</u>	<u>139</u>	<u>155</u>
<u>sec. 19 T. 4 N. S. R. 7 W.</u>	<u>clay</u>	<u>155</u>	<u>215</u>
<u>1/4</u> miles <u>N</u> of <u>Gautier</u>	<u>sand-mixed clay</u>	<u>215</u>	<u>236</u>
(distance) (direction) (nearest town)	<u>clay</u>	<u>236</u>	<u>304</u>
WELL PURPOSE: <u>home</u> (home, irrigation, municipal, industrial)	<u>good sand</u>	<u>304</u>	<u>332</u>
WELL COMPLETION DATA:			
(1) diameter (inches) <u>2"</u>			
(2) total depth (feet) <u>332'</u>			
(3) static water level (feet) <u>20'</u> <u>below</u> top of ground.			
(4) casing <u>galv.</u> , <u>332'</u> (material) (depth)			
(size) if telescope see back.			
(5) screen <u>10'</u> , <u>322'</u> (length) (depth to top)			
<u>008</u> , <u>stainless steel</u> (size) (material)			
(6) pump <u>1/2</u> , <u>6.5</u> (HP) (yield gpm)			
<u>elect.</u> (type power)			
(7) electric log <u>No</u> (yes or no)			
(organization running log)			
(8) how well bottom plugged <u>back</u> <u>pressure valve</u>			
DRILLERS REMARKS:			

CODED

SEP 24 1973

If well telescopes please sketch and show depths.

GROUND LEVEL

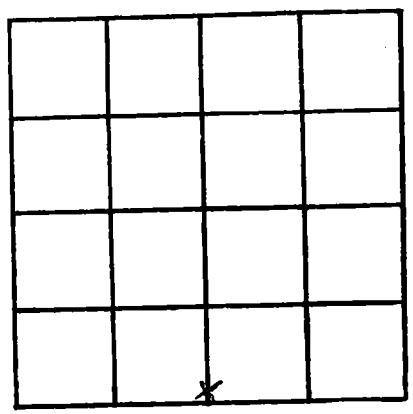

SECTION 17

Please indicate well location X.

ADDITIONAL INFORMATION

Lined area for additional information.

If more than one screen, show locations of each on sketch.