

132

MISSISSIPPI BOARD OF WATER COMMISSIONERS CODED  
416 North State Street  
Jackson, Mississippi 39201

WATER WELL DRILLERS LOG

239  
Jackson  
9-28-73

9-28-73 date well completed Switzer Well Co. firm name Jackson county well located

LANDOWNERS: Gauthier Glass Shopping Center

Harry G. Gauthier, Miss. (mailing address)

WELL LOCATION:

sec. 36 T. 7 S. R. 7 W. 5 miles West of Passaicola

Description of formations encountered	from	to
clay-sand mix	0	23
clay	23	44
sand	44	59
clay	59	65
sand	65	129
clay	129	170
sand	170	172
clay	172	181
sand	181	215
good sand	215	300

WELL PURPOSE: shopping center (home, irrigation, municipal, industrial)

WELL COMPLETION DATA:


- (1) diameter (inches) 2 1/2
- (2) total depth (feet) 301'
- (3) static water level (feet) 28' below top of ground
- (4) casing black (material), 301' (depth) 4" (size) if telescope see back.
- (5) screen 31' (length), 270' (depth to top) 008 (size), stainless steel (material)
- (6) pump 1/2 (HP), (yield gpm) elec. (type power)
- (7) electric log no (yes or no) (organization running log)
- (8) how well bottom plugged back Pressure Valve

NOV 18 1973

MISS. BD. OF WATER COMMISSIONERS

DRILLERS REMARKS:

If well telescopes please sketch and show depths.

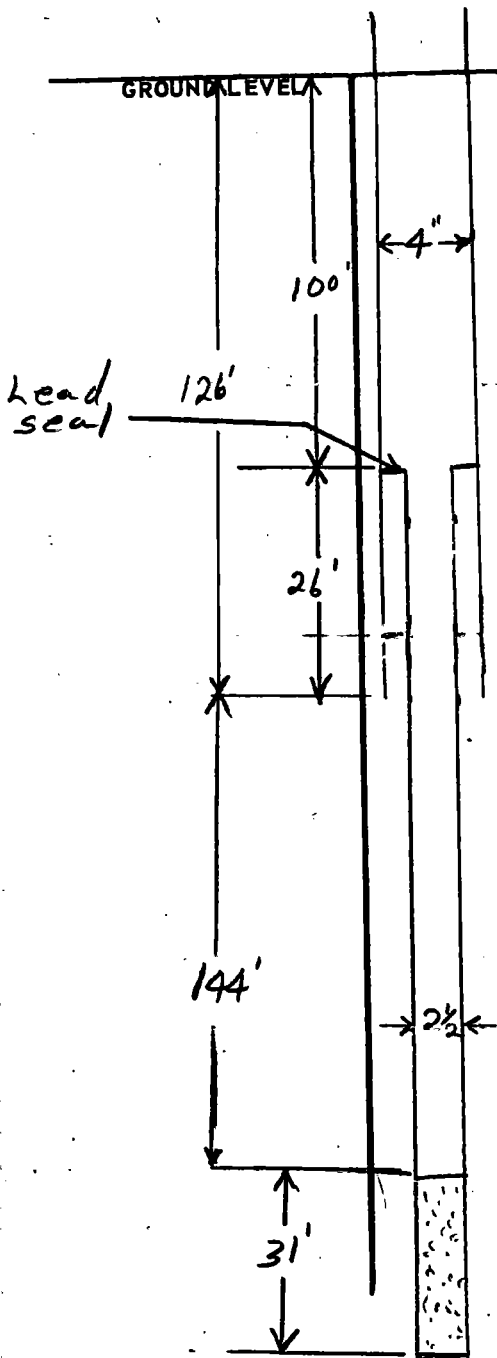

x			

SECTION 36

Please indicate well location X.

ADDITIONAL INFORMATION

If more than one screen, show locations of each on sketch.