

JACKSON
 0241
 9-5-73

MISSISSIPPI
 BOARD OF WATER COMMISSIONERS
 416 North State Street
 Jackson, Mississippi 39201

CODED

WATER WELL DRILLERS LOG

5 Sept 1973 GARLAND WATERWELLS JACKSON
 date well completed firm name county well located

LANDOWNER: TOMMY REEVES
R.T. 4 Box 43E
OCEAN SPRINGS, MISS
 (mailing address)

description of formations encountered	from	to
TOP SOIL	0	10
MED SAND	10	35
BLUE CLAY	35	50
COURSE SAND	50	90
BLUE CLAY	90	150
COURSE SAND	150	212

WELL LOCATION:
 sec. 17 T. 7 S. R. 7 E.
4 miles North of O/S
 (distance) (direction) (nearest town)


WELL PURPOSE: HOME
 (home, irrigation, municipal, industrial)

- WELL COMPLETION DATA:
- (1) diameter (inches) 2"
 - (2) total depth (feet) 210'
 - (3) static water level (feet) 20' below above top of ground
 - (4) casing PVC, 200'
 (material) (depth)
2" if telescope see back.
 (size)
 - (5) screen 10', 210'-200'
 (length) (depth to top)
2", PVC #8 slot
 (size) (material)
 - (6) pump 1 HP, 10-12
 (HP) (yield gpm)
ELECTRIC
 (type power)
 - (7) electric log NB
 (yes or no)
N/A
 (organization running log)
 - (8) how well bottom plugged Plastic
FLOAT BALL

DRILLERS REMARKS:

If well telescopes please sketch and show depths.

GROUND LEVEL

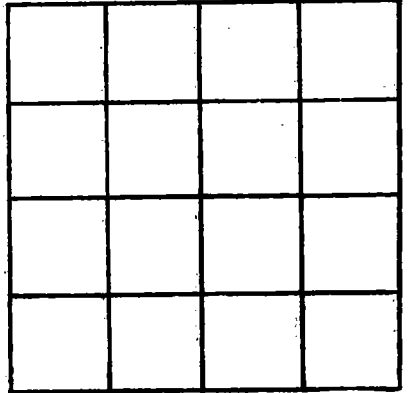

SECTION _____

Please indicate well location X.

ADDITIONAL INFORMATION

If more than one screen, show locations of each on sketch.