

JACKSON
 243
 10-18-73

MISSISSIPPI
 BOARD OF WATER COMMISSIONERS
 416 North State Street
 Jackson, Mississippi 39201

CODED

WATER WELL DRILLERS LOG

COAST WATER WELL SERVICE

Jackson

10/18
 date well completed

1973

firm name

county well located

LANDOWNER: W. A. Ridgell

Et. 1

Hautier, Mo. 39553

(mailing address)

WELL LOCATION:

sec. 36 T. 7 N. R. 7 E

In Hautier, Mo. 39553

(distance) miles (direction) of (nearest town)

WELL PURPOSE:

(home, irrigation, municipal, industrial)

WELL COMPLETION DATA:

- (1) diameter (inches) 2"
 (2) total depth (feet) 300'
 (3) static water level (feet) 25' ^{below} above
 top of ground.

(4) casing p.v.c., 290'
 (material), (depth)

2"
 (size) if telescope see back.

(5) screen 10', 290'
 (length), (depth to top)

2", p.v.c.
 (size), (material)

(6) pump 1/2 hp, 6 g.p.m.
 (HP), (yield gpm)

electric
 (type power)

(7) electric log NO
 (yes or no)

(organization running log)

(8) how well bottom plugged
backwash valve

DRILLERS REMARKS:

description of formations encountered

from

to

Top Soil

0 10

Blue Clay

10 43

Coarse Sand

43 107

Blue Clay

107 129

Coarse Sand

129 172

Blue clay


172 215

Coarse Sand

215 300

If well telescopes please sketch and show depths.

GROUND LEVEL

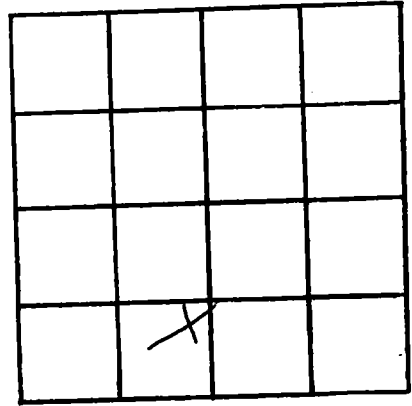

SECTION 36

Please indicate well location X.

ADDITIONAL INFORMATION

If more than one screen,
show locations of each on sketch.