

JACKSON
 0245
 9-10-73

MISSISSIPPI
 BOARD OF WATER COMMISSIONERS
 416 North State Street
 Jackson, Mississippi 39201

CODED

WATER WELL DRILLERS LOG

9/10/1973 date well completed
 COAST WATER WELL SERVICE firm name
 Jackson county well located

LANDOWNER: I. H. Barst
P. M. P. Bank Building
Pascagoula, Mo. 39567
 (mailing address)

description of formations encountered	from	to
	<u>top soil</u>	<u>0</u>
<u>Blue Clay</u>	<u>10</u>	<u>43</u>
<u>Coarse Sand</u>	<u>43</u>	<u>62</u>

WELL LOCATION:
 sec. 38 T 7 N R. 7 E
In Hutton, Mo.
 (distance) miles (direction) of (nearest town)

WELL PURPOSE: home
 (home, irrigation, municipal, industrial)

- WELL COMPLETION DATA:
- (1) diameter (inches) 2"
 - (2) total depth (feet) 62'
 - (3) static water level (feet) 19' (below) above top of ground
 - (4) casing galv. 63'
 (material) (depth)
2" if telescope see back.
 (size)
 - (5) screen 5' 63'
 (length) (depth to top)
2" P. V. C.
 (size) (material)
 - (6) pump _____
 (HP) (yield gpm)


 (type power)
 - (7) electric log No
 (yes or no)

 (organization running log)
 - (8) how well bottom plugged
backwash valve

DRILLERS REMARKS: _____

If well telescopes please sketch and show depths.

GROUND LEVEL

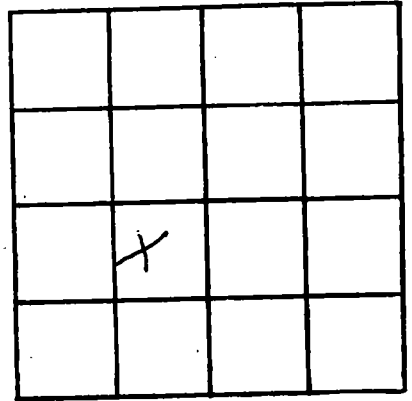

SECTION 3

Please indicate well location X.

ADDITIONAL INFORMATION

If more than one screen,
show locations of each on sketch.