

JACKSON  
 247  
 12-20-73

MISSISSIPPI  
 BOARD OF WATER COMMISSIONERS  
 416 North State Street  
 Jackson, Mississippi 39201

WATER WELL DRILLERS LOG

November 20, 1973 GARLAND WATER WELLS JACKSON  
 date well completed firm name county well located

LANDOWNER: Ronald C Wheat  
Brown Road  
Ocean Springs, Miss  
 (mailing address)

WELL LOCATION:  
 sec. 29 T. 7 R. 7  
3 miles EAST of O/S  
 (distance) (direction) (nearest town)

WELL PURPOSE: Home  
 (home, irrigation, municipal, industrial)

WELL COMPLETION DATA:  
 (1) diameter (inches) 2"  
 (2) total depth (feet) 386'  
 (3) static water level (feet) 34' below top of ground.  
 (4) casing G/Pipe 376'  
 (material) (depth)  
2" if telescope see back.  
 (size)  
 (5) screen 10' 386'-376'  
 (length) (depth to top)  
2" 3/Steel  
 (size) (material)  
 (6) pump 1 10-12  
 (HP) (yield gpm)  
Electric  
 (type power)  
 (7) electric log No  
 (yes or no)  
W/A  
 (organization running log)  
 (8) how well bottom plugged Plastic float ball

description of formations encountered	from	to
Top Soil	0	10
Course Sand	10	65
Blue Clay	65	95
Sand	95	136
Mud	136	373
Course W/B Sand	373	387
Extra fine Sand	387	-

CODED


NOV 23 1973

MISS. Bd. OF WATER COMMISSIONERS

DRILLERS REMARKS:

If well telescopes please sketch and show depths.

GROUND LEVEL

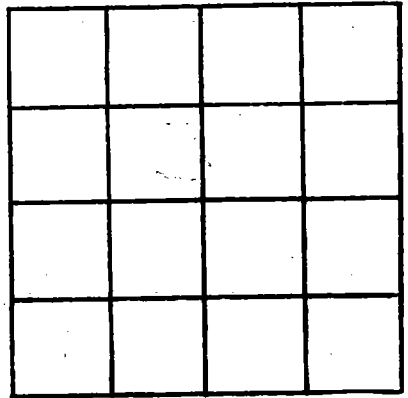

SECTION \_\_\_\_\_

Please indicate well location X.

ADDITIONAL INFORMATION

If more than one screen, show locations of each on sketch.