

JACKSON
 0248
 9-12-73

MISSISSIPPI
 BOARD OF WATER COMMISSIONERS
 416 North State Street
 Jackson, Mississippi 39201

WATER WELL DRILLERS LOG

COASTAL DRILLING & SERVICE CO.

Jackson
 county well located

9/12 1973
 date well completed

ROUTE 1 BOX #618

LANDOWNER:	BILOXI MISS 39532	description of formations encountered	from	to
<i>Bell</i>		Fill	1	5
<i>rt 6 Box 205</i>		top soil	5	30
<i>Ocean Spring Inn</i>		white sand (base)	30	65
(mailing address)		Sandy sand	65	90
WELL LOCATION:		Blue Clay	90	205
sec. <i>31</i> T. <i>2</i> N. R. <i>7</i> E.		fine water sand	205	220
W. <i>S</i>		Soft Blue Clay	220	260
<i>Wore South Fork Tombigbee</i>		hard Blue Clay	260	420
(distance) miles (direction) of (nearest town)		fine water sand	420	440
WELL PURPOSE:		coarse water sand	440	445
(home, irrigation, municipal, industrial)		hard Blue Clay	445	550
WELL COMPLETION DATA:		fine water sand	550	570
(1) diameter (inches) <i>2"</i>		coarse water sand	570	615
(2) total depth (feet) <i>615</i>				
(3) static water level (feet) <i>35</i> below above top of ground.				
(4) casing <i>slw</i> <i>605</i> (material) (depth)				
(size) If telescope see back.				
(5) screen <i>10'</i> <i>605</i> (length) (depth to top)				
<i>2"</i> <i>S.S.</i> (size) (material)				
(6) pump <i>None</i> <i>15</i> (HP) (yield gpm)				
<i>Elk</i> (type power)				
(7) electric log <i>No</i> (yes or no)				
(organization running log)				
(8) how well bottom plugged				
<i>2" hard wood well</i>				
DRILLERS REMARKS:				
<i>good well</i>				

CODED


MISSISSIPPI
 BOARD OF WATER COMMISSIONERS

JAN 20 1974

MISSISSIPPI BOARD OF WATER COMMISSIONERS

If well telescopes please sketch and show depths.

GROUND LEVEL

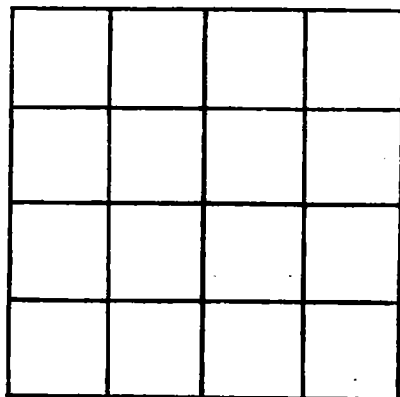

SECTION _____

Please indicate well location X.

ADDITIONAL INFORMATION

If more than one screen, show locations of each on sketch.