

JACKSON

Φ 229 Φ 229

E Log # 215

8/29/74

MISSISSIPPI BOARD OF WATER COMMISSIONERS
416 North State Street
Jackson, Mississippi 39201

CODED

WATER WELL DRILLERS LOG

August 29 1974

Switzer Well Co.

Jackson

date well completed

firm name

county well located

LANDOWNER: Pascagoula Municipal

description of formations encountered

from

to

Separate School District
Singing River Elementary School

Sand	0	5
Clay	5	16
Sand	16	21
Clay + Sand, mixed	21	40
Clay	40	110
Sand	110	135
Clay + Sand, streaked	135	159
Fine Sand	159	179
Sand	179	199
Fair Sand	199	238
Good Sand	238	258
Sand	258	268
Clay	268	292
Sand CODED	292	297
Clay + Sand	297	317
Clay	317	437
Clay + Shale	437	457
Fine Sand	457	477
Fair Sand	477	496
Good Sand	496	517
Sand	517	521
Clay	521	595
Clay + shale	595	615
Sand streaks	615	635
Fair Sand	635	655
Good Sand	655	685
Clay	685	712
Clay + Shale	712	774
Clay	774	873
Clay + Shale	873	914

(mailing address)

WELL LOCATION:

sec 26 T-7 S R-7 W
4 miles S WNW of Pascagoula
(distance) (direction) (nearest town)

WELL PURPOSE: School
(home, irrigation, municipal, industrial)

WELL COMPLETION DATA:


- (1) diameter (inches) 8" x 6"
- (2) total depth (feet) 670'
- (3) static water level (feet) 33.5' below top of ground
- (4) casing steel 630' (material) (depth)
8" x 6" (size) If telescope see back.
- (5) screen 40' 630' (length) (depth to top)
6" (size) Stainless Steel (material)
- (6) pump 10 150 GPM (HP) (yield gpm)
Electric (type power)
- (7) electric log Yes (yes or no)
USGS (organization running log)
- (8) how well bottom plugged Back-wash Valve

DRILLERS REMARKS:

RECORDED
SEP 14 1974

MISS. BD. OF WATER COMMISSIONERS

If well telescopes please sketch and show depths.

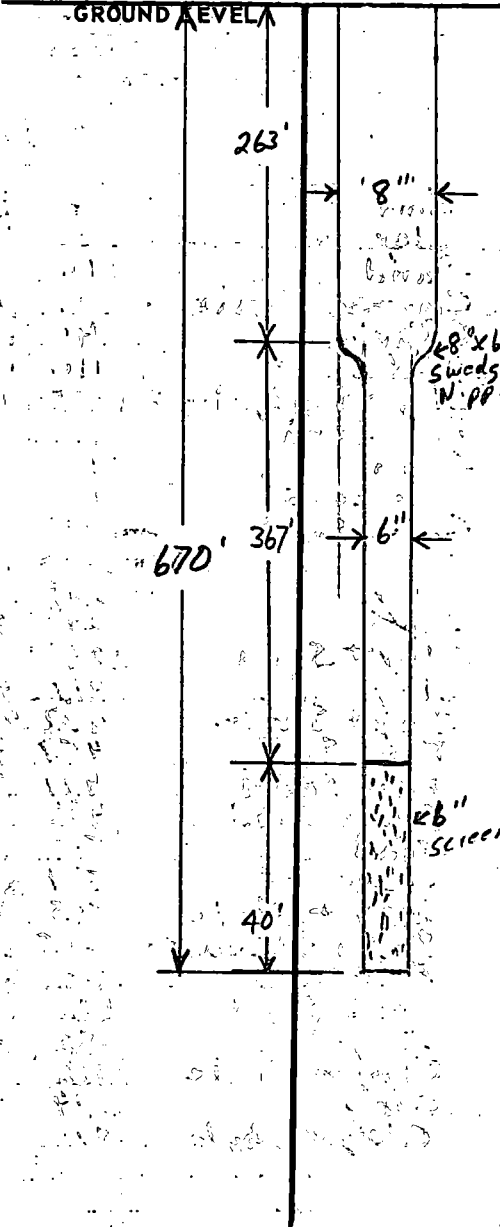

		X	

SECTION 26

Please indicate well location X.

ADDITIONAL INFORMATION

Additional information section with 15 horizontal lines for notes.

If more than one screen, show locations of each on sketch.