

JACKSON
Ø 252
4-23-74

MISSISSIPPI
 BOARD OF WATER COMMISSIONERS **CODED**
 416 North State Street
 Jackson, Mississippi 39201

WATER WELL DRILLERS LOG

4/23 19 74 COAST WATER WELL SERVICE Jackson
 date well completed firm name county well located

LANDOWNER: W.J. Allen

description of formations encountered

from to

233 Travia St.

Biloxi, Miss
 (milling address)

top soil

0 3

Red clay

3 10

WELL LOCATION:

sec. 8 T. 7 R. 7
in Gautier
 (distance) miles (direction) of (nearest town)

fine sand

10 22

Blue clay

22 40

WELL PURPOSE: Camp
 (home, irrigation, municipal, industrial)

Coarse sand

40 50

WELL COMPLETION DATA:

blue CODED

50 60

(1) diameter (inches) 2"
 (2) total depth (feet) 85'
 (3) static water level (feet) 3 below above top of ground.

coarse sand

60 85

(4) casing PVC, 80'
 (material) (depth)
2"
 (size) if telescope see back.

(5) screen 5', 80'
 (length) (depth to top)
2", PVC
 (size) (material)

(6) pump 1/2, 7 1/2
 (HP) (yield gpm)

elec
 (type power)

(7) electric log NO
 (yes or no)

(organization running log)

(8) how well bottom plugged B.W.
Value

DRILLERS REMARKS:


RECEIVED

JUL 12 1974

MISS. BD. OF WATER COMM

If well telescopes please sketch and show depths.

GROUND LEVEL

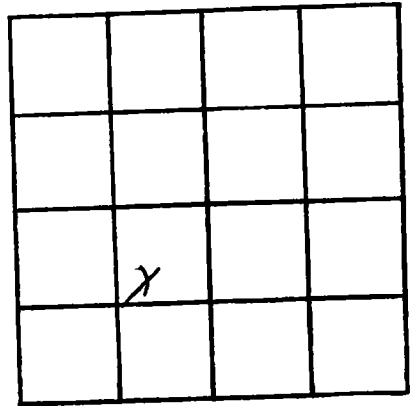

SECTION 8

Please indicate well location X.

ADDITIONAL INFORMATION

If more than one screen, show locations of each on sketch.