

JACKSON
Ø 253
2-23-74

MISSISSIPPI
 BOARD OF WATER COMMISSIONERS
 416 North State Street
 Jackson, Mississippi 39201 **CODED**

WATER WELL DRILLERS LOG

date well completed 2/23 19 74 firm name COAST WATER WELL SERVICE county well located Jackson

LANDOWNER: Billy Lott
3600 Shenrock Dr.
Nautica, Ms.
 (mailing address)

description of formations encountered from to

WELL LOCATION:
 sec. 36 T. 7 S. R. 7 W.
in Nautica
 (distance) miles (direction) of (nearest town)

top soil 0 21
clay + sand 21 42

WELL PURPOSE: home
 (home, irrigation, municipal, industrial)

course sand 42 63
sand + clay 63 84

WELL COMPLETION DATA:

(1) diameter (inches) 2"
 (2) total depth (feet) 270'
 (3) static water level (feet) 20 below above top of ground.

clay 84 105
sand + gravel 105 126

(4) casing PVC 260'
 (material) (depth)
2"
 (size) if telescope see back.

sand + **CODED** 126 147
clay 147 168

(5) screen 10' 260'
 (length) (depth to top)
2" PVC
 (size) (material)

fine sand 168 210
Med. Sand 210 231

(6) pump 1/2 7 1/2
 (HP) (yield gpm)
elec.
 (type power)

Med Sand 231 273

(7) electric log no.
 (yes or no)
 (organization running log)

(8) how well bottom plugged RW
Value

DRILLERS REMARKS:


RECEIVED

JUL 12 1974

MISS. RD. OF WATER COMM.

If well telescopes please sketch and show depths.

GROUND LEVEL

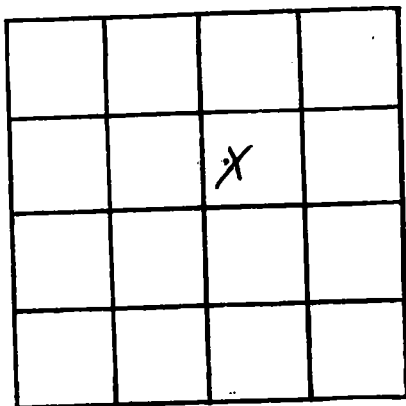

SECTION 36

Please indicate well location X.

ADDITIONAL INFORMATION

If more than one screen,
show locations of each on sketch.