

**JACKSON**  
**Φ 256**  
**12-18-73**

MISSISSIPPI  
 BOARD OF WATER COMMISSIONERS  
 416 North State Street  
 Jackson, Mississippi 39201

**CODED**

**WATER WELL DRILLERS LOG**  
**COAST WATER WELL SERVICE**

12/18 19 73 date well completed firm name *Jackson* county well located

LANDOWNER: *Willie Hill*  
*Rt. 2*  
*Sautier, Ms.*  
 (mailing address)  
 WELL LOCATION:  
 sec. *36* T. *7* R. *7*  
*in Sautier*  
 (distance) miles (direction) of (nearest town)

description of formations encountered	from	to
<i>top soil</i>	<i>0</i>	<i>10</i>
<i>blue clay</i>	<i>10</i>	<i>43</i>
<i>Coarse Sand</i>	<i>43</i>	<i>112</i>
<i>Coarse Sand + Gravel</i>	<i>112</i>	<i>117</i>
<i>Blue Clay</i>	<i>117</i>	<i>172</i>
<i>Coarse Sand</i>	<i>172</i>	<i>279</i>

WELL PURPOSE: *Home*  
 (home, irrigation, municipal, industrial)

WELL COMPLETION DATA:  
 (1) diameter (inches) *2"*  
 (2) total depth (feet) *279*  
 (3) static water level (feet) *15* below above top of ground.  
 (4) casing *PVC*, *269'*  
 (material) (depth)  
*2"* if telescope see back.  
 (size)  
 (5) screen *10'*, *269'*  
 (length) (depth to top)  
*2"*, *PVC*  
 (size) (material)  
 (6) pump \_\_\_\_\_ (HP) \_\_\_\_\_ (yield gpm)  
*elec*  
 (type power)  
 (7) electric log *NO*  
 (yes or no)  
 \_\_\_\_\_  
 (organization running log)

(8) how well bottom plugged  
*Backwash valve*

DRILLERS REMARKS:


**RECEIVED**

**JUL 12 1974**

**MISS. BD. OF WATER COMM**

If well telescopes please sketch and show depths.

GROUND LEVEL

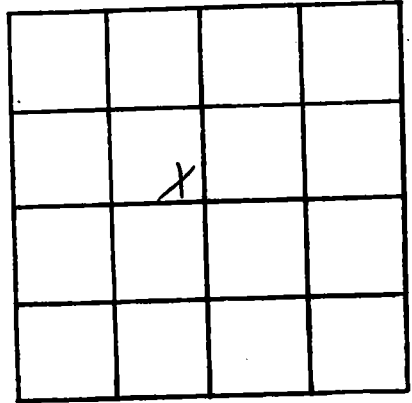

SECTION 36

Please indicate well location X.

ADDITIONAL INFORMATION

If more than one screen,  
show locations of each on sketch.