

Jackson
 257
 8-26-74

MISSISSIPPI
 BOARD OF WATER COMMISSIONERS
 416 North State Street
 Jackson, Mississippi 39201

INDEXED

WATER WELL DRILLERS LOG

August 26 1974 Garland Wright Water Wells Jackson
 date well completed firm name county well located


LANDOWNER: Mr. Gary Davis
 Rex Rod Coast Co., Hwy 90
 Gautier, Miss
 (mailing address)

description of formations encountered	from	to
Top Soil	1	3
Sand	3	178
Mud	178	192
Sand	192	201
Mud + Shell	201	205
Sand	205	212
Mud	212	221
Shell (Stracks) + Sand	221	235
Sand	235	264

WELL LOCATION:
 sec. 34 T. 7 N R. 7 E
 S W
 3 miles West of Gautier
 (distance) (direction) (nearest town)

WELL PURPOSE: OFFICE
 (home, irrigation, municipal, industrial)

- WELL COMPLETION DATA:
- (1) diameter (inches) 2"
 - (2) total depth (feet) 262'
 - (3) static water level (feet) 19' below top of ground.
 - (4) casing Gal. Pipe, 252' (material) (depth)
 2" (size) if telescope see back.
 - (5) screen 10' (length), 252'-262' (depth to top)
 2" (size), Stainless Steel (material)
 - (6) pump 1/2 HP (HP), 10 (yield gpm)
 Electric (type power)
 - (7) electric log No (yes or no)
 - (8) how well bottom plugged Float Ball

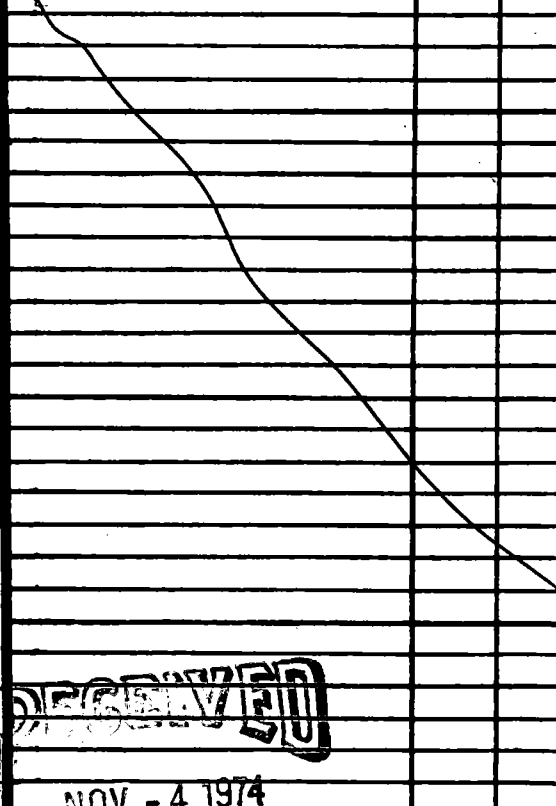

RECEIVED


NOV - 4 1974

DRILLERS REMARKS:

MISS. BD. OF WATER COMM

If well telescopes please sketch and show depths.

GROUND LEVEL

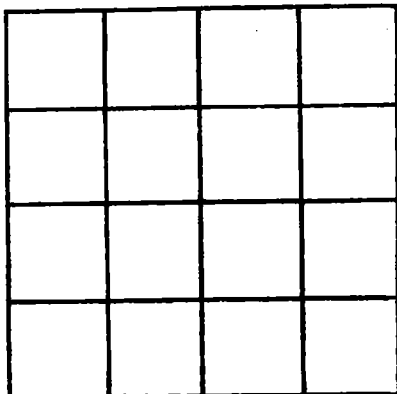

SECTION _____

Please indicate well location X.

ADDITIONAL INFORMATION

Lined area for providing additional information.

If more than one screen, show locations of each on sketch.