

JACKSON
 259
 1-9-74

MISSISSIPPI
 BOARD OF WATER COMMISSIONERS CODED
 416 North State Street
 Jackson, Mississippi 39201

WATER WELL DRILLERS LOG

1/4 1974 date well completed
 COAST WATER WELL SERVICE firm name
 Jackson county well located

LANDOWNER: James D. Santini

description of formations encountered

from to

2857 ~~Highway~~ Gregory St.
Mass Point, Miss
 (mailing address)

top soil 0 21

coarse sand 21 126

WELL LOCATION:

sec. 19 T. 8 S. R. 7 W.
6 miles S.E. of Ocean Springs
 (distance) (direction) (nearest town)

sand & clay 126 188

clay 168 189

fine sand 189 210

WELL PURPOSE: camp
 (home, irrigation, municipal, industrial)

clay CODED 210 231

WELL COMPLETION DATA:

(1) diameter (inches) 2"

sand & clay 231 294

(2) total depth (feet) 370'

clay 294 336

(3) static water level (feet) 20 below above top of ground.

Med. sand 336 370

(4) casing PVC, 360'
 (material) (depth)

2" if telescope see back.
 (size)

(5) screen 10' 360'
 (length) (depth to top)

2" PVC
 (size) (material)

(6) pump 1/2 7
 (HP) (yield gpm)


elec.
 (type power)

(7) electric log NO
 (yes or no)

(organization running log)

(8) how well bottom plugged B.W. Value

DRILLERS REMARKS:

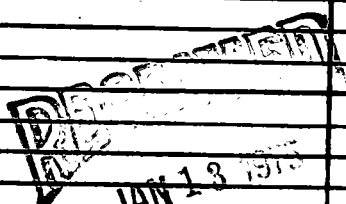

MISS. BD. OF WATER COMM.

