

Jackson
 0260
 5-30-74

MISSISSIPPI
 BOARD OF WATER COMMISSIONERS
 416 North State Street
 Jackson, Mississippi 39201

WATER WELL DRILLERS LOG

CODED

COAST WATER WELL SERVICE

5/30 1974
 date well completed

firm name

Jackson
 county well located

LANDOWNER: J. N. Sadner

Rt. 2 Box 388C
 Gautier, Miss.
 (mailing address)

description of formations encountered	from	to
top soil + blue clay	0	32
coarse sand	32	97
blue clay	97	120
med. sand	120	230

WELL LOCATION:

sec. 12 T. 7 R. 7
 4 1/2 miles N-W of Gautier
 (distance) (direction) (nearest town)

WELL PURPOSE: Home
 (home, irrigation, municipal, industrial)


WELL COMPLETION DATA:

- (1) diameter (inches) 2"
- (2) total depth (feet) 230'
- (3) static water level (feet) 18 below top of ground.
- (4) casing PVC, 220' (material), (depth)
 2" (size) if telescope see back.
- (5) screen 10' 220' (length), (depth to top)
 2" (size) PVC (material)
- (6) pump (HP) (yield gpm)
 (type power)
- (7) electric log NO (yes or no)
 (organization running log)

CODED

(8) how well bottom plugged
 Back Wash Valve

DRILLERS REMARKS:

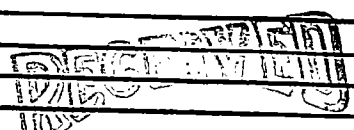

JAN 13 1975

If well telescopes please sketch and show depths.

GROUND LEVEL

	X		

SECTION 12

Please indicate well location X.

ADDITIONAL INFORMATION

If more than one screen, show locations of each on sketch.