

MISSISSIPPI
BOARD OF WATER COMMISSIONERS
416 North State Street
Jackson, Mississippi 39201

CODED

WATER WELL DRILLERS LOG

Jackson
Φ 261
7-1-74

7/1 19 74 COAST WATER WELL SERVICE Jackson
date well completed firm name county well located

LANDOWNER: Betty Ballard

P.O. Box 169
Hautier, Mo
(mailing address)

WELL LOCATION:

sec 36 T 7 N R 7 E
in Hautier
(distance) miles (direction) of (nearest town)

WELL PURPOSE: Home
(home, irrigation, municipal, industrial)

WELL COMPLETION DATA:

- (1) diameter (inches) 2"
- (2) total depth (feet) 290'
- (3) static water level (feet) 22 below top of ground.
- (4) casing PVC 280'
(material) (depth)
2" (size) if telescope see back.
- (5) screen 10' 280'
(length) (depth to top)
2" PVC
(size) (material)
- (6) pump 1 HP 9 (yield gpm)
elec (type power)
- (7) electric log NO
(yes or no)

(organization running log)

(8) how well bottom plugged A.W.
Water

DRILLERS REMARKS:

description of formations encountered

	from	to
top soil + yellow clay	0	18
coarse sand	18	24
yellow clay	24	34
med. sand	34	63
blue clay	63	86
coarse sand	86	156
blue clay	156	200
coarse sand	200	290

CODED


RECORDED
INDEXED

JAN 13 1975

MISS. Bd. OF WATER COMM

If well telescopes please sketch and show depths.

GROUND LEVEL

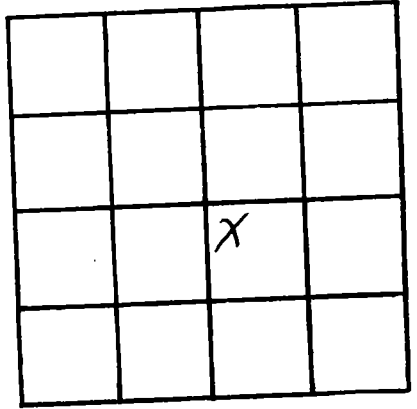

SECTION 36

Please indicate well location X.

ADDITIONAL INFORMATION

If more than one screen,
show locations of each on sketch.