

**Jackson**  
**0262**  
**5-28-74**

**MISSISSIPPI**  
**BOARD OF WATER COMMISSIONERS CODED**  
 416 North State Street  
 Jackson, Mississippi 39201

**WATER WELL DRILLERS LOG**

5/28 1974 COAST WATER WELL SERVICE Jackson  
 date well completed firm name county well located

**LANDOWNER:** P. B. Lawler  
P.O. Box 406  
Miss Point Ms  
 (mailing address)

**WELL LOCATION:**  
 sec. 36 T 7 S R. 7 E  
in Gautier  
 (distance) miles (direction) of (nearest town)

**WELL PURPOSE:** Store  
 (home, irrigation, municipal, industrial)

**WELL COMPLETION DATA:**

- (1) diameter (inches) 2"
- (2) total depth (feet) 270'
- (3) static water level (feet) 15 below top of ground.
- (4) casing PVC, 260'  
 (material) (depth)  
2"  
 (size) if telescope see back.
- (5) screen 10', 260'  
 (length) (depth to top)  
2", PVC  
 (size) (material)
- (6) pump 1/2, 8 1/2  
 (HP) (yield gpm)  
elec.  
 (type power)
- (7) electric log NO  
 (yes or no)
- (organization running log)
- (8) how well bottom plugged B.W.  
value


description of formations encountered	from to	
	feet	feet
<u>top soil</u>	<u>0</u>	<u>18</u>
<u>yellow clay</u>		
<u>Coarse Sand</u>	<u>18</u>	<u>24</u>
<u>yellow clay</u>	<u>24</u>	<u>34</u>
<u>med. sand</u>	<u>34</u>	<u>63</u>
<u>blue clay</u>	<u>63</u>	<u>86</u>
<u>CODED</u>		
<u>Coarse Sand</u>	<u>86</u>	<u>156</u>
<u>blue clay</u>	<u>156</u>	<u>200</u>
<u>Coarse Sand</u>	<u>200</u>	<u>270</u>

**RECEIVED WITHIN 15 MIN**  
**NOV 15 1974**  
**JAN 15 1975**

**DRILLERS REMARKS:**

If well telescopes please sketch and show depths.

GROUND LEVEL

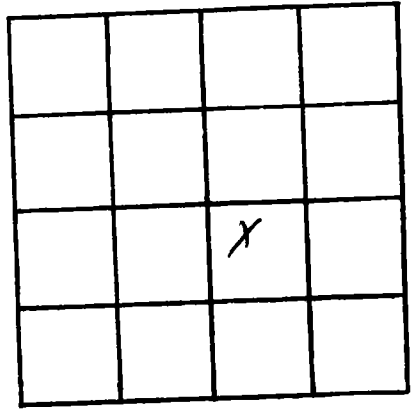

SECTION 36

Please indicate well location X.

ADDITIONAL INFORMATION

If more than one screen, show locations of each on sketch.