

Jackson
 0265
 4-12-74

MISSISSIPPI
 BOARD OF WATER COMMISSIONERS
 416 North State Street
 Jackson, Mississippi 39201

WATER WELL DRILLERS LOG

CODED

Jackson
 Harrison

April 12 1974 McGee well works
 date well completed firm name

county well located

LANDOWNER: Joe Hill, Jr.
 107 Keesler Circle
 Biloxi, Miss.
 (mailing address)

WELL LOCATION:
 sec. 31 T. 7 N. R. 7 E
 6 miles E of Ocean Springs
 (distance) (direction) (nearest town)

WELL PURPOSE: Home
 (home, irrigation, municipal, industrial)

WELL COMPLETION DATA:
 1) diameter (inches) 700 4 in.
 488 2 in.

2) total depth (feet) 588'

3) static water level (feet) 10' below above top of ground.

4) casing P.V.C. 578'
 (material) (depth)

5) screen 10' (length) (depth to top)

2" S.S. (size) (material)


6) pump 1 22 (HP) (yield gpm)
 Electric (type power)

7) electric log NO (yes or no)

(organization running log)

8) how well bottom plugged sand
 shanks back wash valve

description of formations encountered	from	to
Blue clay	0	14
sand	14	37
shale	37	74
fine sand	74	124
shale	124	260
shale	260	309
fine sand	309	323
shale	323	378
Blue clay	378	441
shale	441	473
fine sand	473	492
shale	492	555
shale	555	588

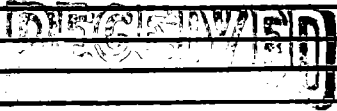

DRILLERS REMARKS:

JAN 21 1974

COMM

If well telescopes please sketch and show depths.

GROUND LEVEL

		X	

SECTION 31

Please indicate well location X.

ADDITIONAL INFORMATION

If more than one screen, show locations of each on sketch.