

JACKSON
 D 267
 8-30-74

MISSISSIPPI
 BOARD OF WATER COMMISSIONERS
 416 North State Street
 Jackson, Mississippi 39201

CODED

WATER WELL DRILLERS LOG

8/30 1974 date well completed
 COAST WATER WELL SERVICE firm name
 Jackson county well located


LANDOWNER: <u>Terry Slackford</u>	description of formations encountered	from	to
<u>Rt. 2</u>			
<u>Gautier, Ms.</u> (mailing address)	<u>top soil</u>	<u>0</u>	<u>42</u>
	<u>Sand - c</u>	<u>42</u>	<u>100</u>
WELL LOCATION: sec. <u>34</u> T. <u>7</u> S. R. <u>7</u> W. <u>3 1/2</u> miles <u>W</u> of <u>Gautier</u> (distance) (direction) (nearest town)	<u>Blue Clay</u>	<u>100</u>	<u>107</u>
	<u>sand - M</u>	<u>107</u>	<u>129</u>
WELL PURPOSE: <u>Threshers</u> (home, irrigation, municipal, industrial)	<u>Blue Clay</u>	<u>129</u>	<u>162</u>
WELL COMPLETION DATA:	<u>sand - M.</u>	<u>162</u>	<u>250</u>
(1) diameter (inches) <u>2"</u>			
(2) total depth (feet) <u>250'</u>			
(3) static water level (feet) <u>25</u> below above top of ground.			
(4) casing <u>Pvc</u> (material), <u>240'</u> (depth) <u>2"</u> (size) if telescope see back.			
(5) screen <u>10'</u> (length), <u>240'</u> (depth to top) <u>2"</u> (size), <u>Pvc</u> (material)			
(6) pump <u>1</u> (HP), <u>8 1/2</u> (yield gpm) <u>elec.</u> (type power)			
(7) electric log <u>N/O</u> (yes or no) (organization running log)			
(8) how well bottom plugged <u>B W 2</u>			
DRILLERS REMARKS:			

RECEIVED
 MAY 15 1975

MISS. BD. OF WATER COMM

If well telescopes please sketch and show depths.

GROUND LEVEL

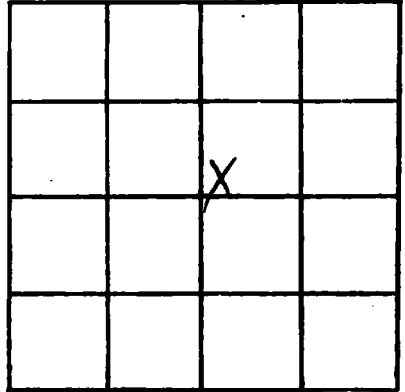

SECTION 34

Please indicate well location X.

ADDITIONAL INFORMATION

If more than one screen, show locations of each on sketch.