

JACKSON
Φ268
8-24-74

MISSISSIPPI
 BOARD OF WATER COMMISSIONERS
 416 North State Street
 Jackson, Mississippi 39201

CODED

WATER WELL DRILLERS LOG

8/24 1974 COAST WATER WELL SERVICE Jackson
 date well completed firm name county well located

LANDOWNER: <u>John Isbual</u>	description of formations encountered	from	to
<u>Pt. 1</u>			
<u>Hautier, Mo.</u> (mailing address)	<u>top soil</u>	<u>0</u>	<u>10</u>
WELL LOCATION: sec. <u>14</u> T <u>8</u> N R <u>7</u> W <u>2</u> miles <u>SW</u> of <u>Hautier</u> (distance) (direction) (nearest town)	<u>Blue clay</u>	<u>10</u>	<u>62</u>
WELL PURPOSE: <u>Home</u> (home, irrigation, municipal, industrial)	<u>Sand - c</u>	<u>62</u>	<u>103</u>
WELL COMPLETION DATA: (1) diameter (inches) <u>2"</u>	<u>Blue Clay</u>	<u>103</u>	<u>123</u>
(2) total depth (feet) <u>602'</u>	<u>Sand - c</u>	<u>123</u>	<u>150</u>
(3) static water level (feet) <u>24</u> below top of ground.	<u>Blue Clay</u>	<u>150</u>	<u>164</u>
(4) casing <u>PVC</u> , <u>592'</u> (material) (depth)	<u>Sand - c</u>	<u>164</u>	<u>358</u>
<u>2"</u> (size) If telescope see back.	<u>Blue Clay</u>	<u>358</u>	<u>382</u>
(5) screen <u>PVC</u> , <u>592'</u> (length) (depth to top)	<u>Sand - c</u>	<u>382</u>	<u>392</u>
<u>2"</u> (size), <u>PVC</u> (material)	<u>Blue Clay</u>	<u>392</u>	<u>495</u>
(6) pump <u>1</u> (HP), <u>9</u> (yield gpm)	<u>Sand - c</u>	<u>495</u>	<u>602</u>
<u>elec.</u> (type power)			
(7) electric log <u>NO</u> (yes or no)			
(organization running log)			
(8) how well bottom plugged <u>B.W.V.</u>			
DRILLERS REMARKS:			


RECEIVED

MAY 16 1975

MISS. BD. OF WATER COMM

If well telescopes please sketch and show depths.

GROUND LEVEL

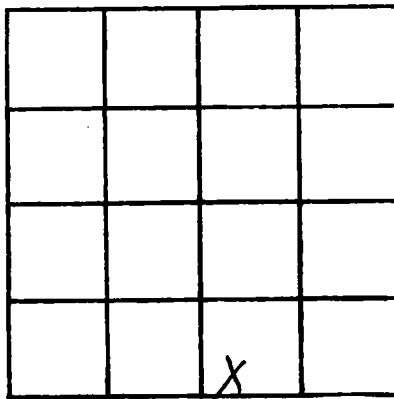

SECTION 14

Please indicate well location X.

ADDITIONAL INFORMATION

If more than one screen, show locations of each on sketch.