

Jackson  
 0271  
 5-5-75

MISSISSIPPI  
 BOARD OF WATER COMMISSIONERS  
 416 North State Street  
 Jackson, Mississippi 39201

CODED

WATER WELL DRILLERS LOG  
 COASTAL DRILLING & SERVICE CO.

5/5 1975  
 date well completed

ROUTE 1 BOX 418

Jackson  
 county well located

LANDOWNER: Mike  
 BILOXI, MISS 39532

description of formations encountered

from to

Impel  
 Ocean Spring Min  
 (mailing address)

Top Soil	1	3
White Sand	3	180
Soft Clay	18	315
Clay	315	320
Shell	320	325
Soft Clay	325	360
cuphead clay	360	505
fine water sand	505	525
Rough water sand	525	565

WELL LOCATION: 135

sec 32 T 7 N R 7 E 135  
 S W  
 Fountainbleau  
 (distance) (direction) (nearest town)


WELL PURPOSE: home  
 (home, irrigation, municipal, industrial)

WELL COMPLETION DATA:

- (1) diameter (inches) 2"
- (2) total depth (feet) 565'
- (3) static water level (feet) 40 below above top of ground
- (4) casing PVC 555'  
 (material) (depth)
- \_\_\_\_\_ If telescope see back.  
 (size)
- (5) screen 10' 555'  
 (length) (depth to top)  
 2" PVC  
 (size) (material)
- (6) pump 15 13  
 (HP) (yield gpm)  
 Ele  
 (type power)
- (7) electric log Yes  
 (yes or no)
- \_\_\_\_\_ (organization running log)

(8) how well bottom plugged  
 2" backwash tube

DRILLERS REMARKS:

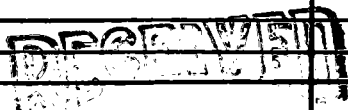


JUL 17 1975

MISS. BD. OF WATER COMM

If well telescopes please sketch and show depths.

GROUND LEVEL

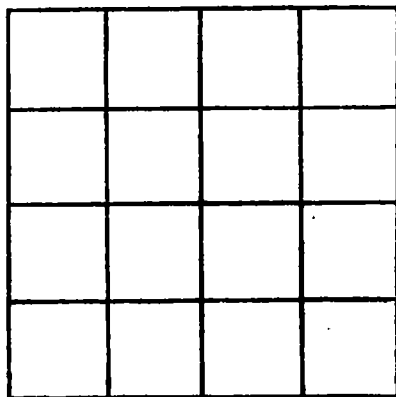

SECTION \_\_\_\_\_

Please indicate well location X.

ADDITIONAL INFORMATION

If more than one screen, show locations of each on sketch.