

Jackson  
 276  
 10/9/74

MISSISSIPPI  
 BOARD OF WATER COMMISSIONERS  
 416 North State Street  
 Jackson, Mississippi 39201

WATER WELL DRILLERS LOG

10/9 1974 date well completed  
 COAST WATER WELL SERVICE firm name  
 Jackson county well located

LANDOWNER: John Kiel  
 Rt. 1  
 Gautier, Ms.  
 (mailing address)

WELL LOCATION:  
 sec. 14 T 8 S R 7 W  
 in Gautier  
 (distance) miles (direction) of (nearest town)

WELL PURPOSE: Home  
 (home, irrigation, municipal, industrial)

WELL COMPLETION DATA:

(1) diameter (inches) 2"  
 (2) total depth (feet) 600'  
 (3) static water level (feet) 22 below top of ground.  
 (4) casing PVC, 590' (material) (depth)  
 2" if telescope see back. (size)  
 (5) screen 10' 590' (length) (depth to top)  
 2" PVC (size) (material)  
 (6) pump 1/2 hp. 15 (HP) (yield gpm)  
 elec. (type power)  
 (7) electric log NO (yes or no)  
 (organization running log)  
 (8) how well bottom plugged B.W.H.


description of formations encountered	from	to
top soil	0	15
Blue clay	15	60
coarse sand	60	107
Blue clay	107	143
coarse sand	143	195
Blue clay	195	220
coarse sand	220	346
Blue clay	346	370
coarse sand	370	394
Blue clay	394	500
Med. sand	500	585
coarse sand	585	602

DRILLERS REMARKS:

RECEIVED  
 OCT 22 1974  
 COMB

If well telescopes please sketch and show depths.

GROUND LEVEL

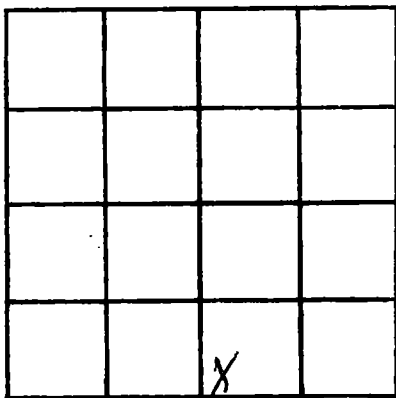

SECTION 14

Please indicate well location X.

ADDITIONAL INFORMATION

If more than one screen, show locations of each on sketch.