

JACKSON
 0285
 4/11/79

MISSISSIPPI
 BOARD OF WATER COMMISSIONERS
 416 North State Street
 Jackson, Mississippi 39201

CODED

WATER WELL DRILLERS LOG

4-11-1979 date well completed
 1979 Coastal Water Well Drilling firm name
 Jackson county well located

LANDOWNER: Argyris River Motel
2212-B Street
Meridian, Miss 39301
 (mailing address)

description of formations encountered	from	to
	Red Clay	0
Blue Clay	6	45
Sand C	45	75

WELL LOCATION:
 sec. 35 T. 7 S. R. 7 W.
 in _____ miles of Leakesville
 (distance) (direction) (nearest town)

CODED

WELL PURPOSE:
 (home, irrigation, municipal, industrial)

- WELL COMPLETION DATA:
- diameter (inches) 4"
 - total depth (feet) _____
 - static water level (feet) 15' below top of ground.
 - casing PVC 75'
 (material) (depth)
4" (size) if telescope see back.
 - screen 15' 60'
 (length) (depth to top)
4" (size) PVC (material)
 - pump 5 hp 100 gal
 (HP) (yield gpm)
Electric (type power)
 - electric log No.
 (yes or no)
- _____
 (organization running log)

(8) how well bottom plugged
back wash valve

DRILLERS REMARKS:


Miss. Board of Water Comm.

MAY 29 1979

RECEIVED

If well telescopes please sketch and show depths.

GROUND LEVEL

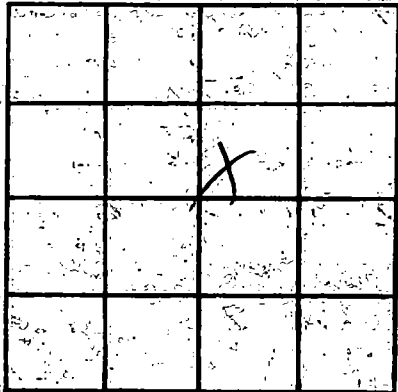

SECTION 35

Please indicate well location X.

ADDITIONAL INFORMATION

Multiple horizontal lines for additional information.

If more than one screen, show locations of each on sketch.