

Jackson
 #287
 11-16-79
 Elog #232

MISSISSIPPI
 BOARD OF WATER COMMISSIONERS
 416 North State Street
 Jackson, Mississippi 39201

CODED

WATER WELL DRILLERS LOG

11-16-79 date well completed 1979 Robert & Ratzliff Co. Inc. firm name Jackson county well located

LANDOWNER Mr. Sandhill
Crane National Wildlife
Refuge
 (mailing address)

description of formations encountered	from	to
top soil	0	20
Clay	20	120
sand	120	240
Clay	240	405

WELL LOCATION:
 sec. 11 T. 75 S. R. 7 E. W.
3 miles N of Thatties
 (distance) (direction) (nearest town)

WELL PURPOSE: well design
 (home, irrigation, municipal, industrial)

WELL COMPLETION DATA:

(1) diameter (inches) 6 x 4

(2) total depth (feet) 190'

(3) static water level (feet) 15' below above top of ground.

(4) casing Steel, 162',
 (material) (depth)
 (size) If telescope see back.

(5) screen 30', 160
 (length) (depth to top)
4", SS
 (size) (material)

(6) pump —, Best
 (HP) (yield gpm)
 (type power)

(7) electric log —
 (yes or no)
MGS
 (organization running log)

(8) how well bottom plugged BPT

CODED

DRILLERS REMARKS:


DEPT. OF NATURAL RESOURCES
 BUREAU OF LAND & WATER RESOURCES

MAR 24 1980

RECEIVED

If well telescopes please sketch and show depths.

GROUND LEVEL

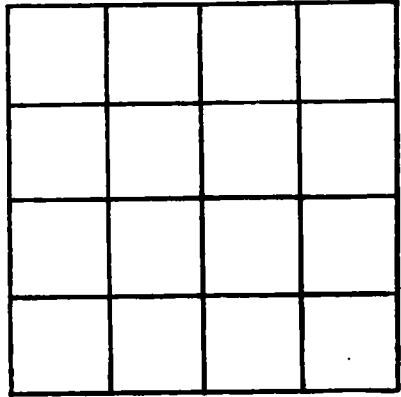

SECTION _____

Please indicate well location X.

ADDITIONAL INFORMATION

If more than one screen, show locations of each on sketch.