

MISSISSIPPI DEPARTMENT OF NATURAL RESOURCES

Bureau of Land and Water Resources

Southport Mall

P.O. Box 10631

Jackson, Mississippi 39209

CODED

WATER WELL DRILLERS LOG

Coast Water Well Serv. Jackson

JACKSON
 Q 292
 2-18-81
 2-18-81

date well completed

firm name

county well located

LANDOWNER:

description of formations encountered

from

to

Macey Ladner
 P.O. Box 12
 Gautier, Miss. 39553
 (mailing address)

Sandy T. Soil

0 20

WELL LOCATION:

Gray Clay

20' 30'

sec. 36 T. 7A R. 7E
 (distance) miles (direction) of *GAUTIER*
 (nearest town)

C sand

30' 125'

B. Clay

125' 130'

C sand & B.

130' 175'

WELL PURPOSE: *home*
 (home, irrigation, municipal, industrial)

B. Clay

175' 253'

WELL COMPLETION DATA:

M. Sand

253' 260'

- (1) diameter (inches) 3"
- (2) total depth (feet) 260'
- (3) static water level (feet) 30' below above top of ground.
- (4) casing PVC 250'
 (material) (depth)
- 2" if telescope see back.
 (size)
- (5) screen 10' 250'
 (length) (depth to top)
- 2" PVC
 (size) (material)
- (6) pump 1/2 HP 9 1/2
 (HP) (yield gpm)
- Electric
 (type power)
- (7) electric log No.
 (yes or no)

(organization running log)

(8) how well bottom plugged
backwash valve

DEPT. OF NATURAL RESOURCES
 BUREAU OF LAND & WATER RESOURCES

APR - 7 1981


RECEIVED

DRILLERS REMARKS:

If well telescopes please sketch and show depths.

03000

GROUND LEVEL

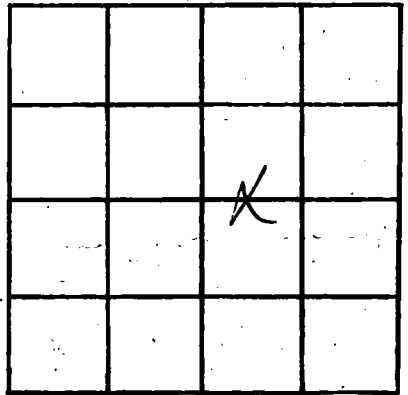

SECTION 36

Please indicate well location X.

ADDITIONAL INFORMATION

If more than one screen, show locations of each on sketch.