

MISSISSIPPI DEPARTMENT OF NATURAL RESOURCES

Bureau of Land and Water Resources

Southport Mall

P.O. Box 10631

Jackson, Mississippi 39209

CODED

WATER WELL DRILLERS LOG

JACKSON
Q 293
3-19-81

3-19-81 date well completed
81 Coast Water Well Sew. firm name
Jackson county well located

LANDOWNER:

A. J. Knight

description of formations encountered

from

to

3717 Kamie Dr.
Gautier, Miss.
(mailing address) 39553

Top soil 0 3'

WELL LOCATION:

sec. 36 T. 7_S R. 7_W
1N miles (distance) of GAUTIER (direction) (nearest town)

Gray Clay 3 19'

WELL PURPOSE:

(home, irrigation, municipal, industrial)

None

Blue Clay 19' 49'

WELL COMPLETION DATA:

(1) diameter (inches) 2"
(2) total depth (feet) 292'
(3) static water level (feet) 20' below top of ground.

White Coarse sand 49' 71'

(4) casing PVC (material) 282' (depth)

Blue Clay 71' 119'

(5) screen 2" (size) 10' (length) 282' (depth to top)

blue clay and streak of sand 119' 139'

(6) pump 1/2 HP (HP) 13 (yield gpm)

Blue Clay 139' 190'

(7) electric log (yes or no) No

Gray Coarse sand 190 292

(8) how well bottom plugged

(organization running log)

Backwash Valve


DRILLERS REMARKS:

DEPT. OF NATURAL RESOURCES
BUREAU OF LAND & WATER RESOURCES

APR -9 1981
RECEIVED

If well telescopes please sketch and show depths.

GROUND LEVEL

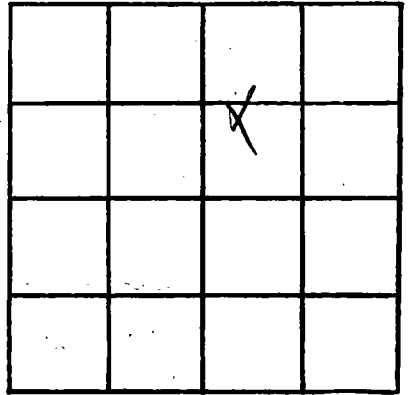

SECTION 36

Please indicate well location X.

ADDITIONAL INFORMATION

If more than one screen, show locations of each on sketch.